

APR 27 1995

CRAWFORD COUNTY
PEER GROUP APPROVAL
DATE Dec 29, 1994
MEM

LIBER 3 PAGE 172 COMMISSION

LAND CORNER RECORDATION CERTIFICATE

Filing Requirement of Act 74, Mich. P.A. 1970

For corners in

Crawford (County)	Located In:	Corner Code #
1. Public Land Survey	T 25N R 3W	C - 13
	T R	
	T R	
	T R	
2. Property Controlling in Section	S T R	
	S T R	
3. Miscellaneous Property in Sec.	S T R	
	S T R	

STATE OF MICHIGAN
COUNTY OF CRAWFORD
FILED FOR RECORD THIS
30th DAY OF Dec., 1994
4:20 am/0m IN LIBER 3
PAGE 172
E. J. Williams
Register of Deeds
Register of Deeds Stamp & File Number

4. Lot No. _____, Recorded Plat _____
5. Private Claims _____

I, Marvin E. Myers, in a field survey on December 13, 19 94, do hereby certify that under requirements of P.A. 74, Michigan P.A. of 1970, the corner points mentioned in lines 1 and 2 above were in conformance with regulations and rules therefore as required in the current manual of survey instructions of the United States Department of the Interior, Bureau of Land Management or by a decree of a Court of Law and/or that the corner points mentioned in lines 3, 4 and 5 above were in conformance with the rules of the Michigan Board of Land Surveyors or by a Decree of a Court of Law; established, re-established, monumented, re-monumented, recovered, found as expressed below.

	A	B	C	D	E	F	G	H	I	J	K	L	M
2	6	5	4	3	2	1							
3													
4	7	8	9	10	11	12							
5													
6	18	17	16	15	14	13							
7													
8	19	20	21	22	23	24							
9													
10	30	29	28	27	26	25							
11													
12	31	32	33	34	35	36							
13													

NOTE: Not more than 4 corners, all in the same town and range, may be recorded on this certificate.

A. Description of original monument and accessories and/or subsequent restoration:


GLO-A.P. Brewer 1852 Mon-Set Post WIT: 7" W.Oak N10°E 15 lks. 10" W.Oak N39°W 50 lks.	G. Henning Oct. 21, 1976 L.156, pg.279 Mon-Fd. 1/2" bar WIT: 12" W.Oak N40°E 79.0' 3" Y.Pine N30°W 102.2' Conc. Mon. North 33.0'
R. Ostling June 11, 1954 Mon-Fd. 1/2" bar WIT: BT 6" B.Oak S45°W 42.3' BT 16" B.Oak N15°W 63.3' BT 7" W.Oak S60°E 72.1'	

B. Description of corner evidence found and/or method applied in restoring or reestablishing corner:

Monument - Found 1/2" x 7" iron bar 0.40' South of centerline County Road 200 over 1/2" x 28" iron bar in center of rock mound
WIT: Fd. conc. mon. N07°E 32.90'
Fd. blaze S. face 17" B.Oak N15°W 63.25'
Fd. 16" W.Oak N47°E 79.05'
Fd. 13" W.Oak S52°E 73.00'
Accepted as the best available evidence of the position of the Original Corner.

C. Description of monument for corner and accessories established to perpetuate locating the position of the corner:

Mon-Set std. Crawford County Mon. stamped "T25N R3W C-13 31600" in exact location of 1/2" bar in Mon. Box
WIT: Fd. conc. mon. N07°E 32.90'
Set wit. tag & nail N. side 15" W.Oak S55°E 76.8'
Set wit. tag & nail SE side 11" B.Oak S45°W 64.29'
Set wit. tag & nail NE side 9" R.Pine n35°W 67.81'
Fd. blaze S. face 17" B.Oak N15°W 63.25'
Set wit. tag & nail SE side 16" W.Oak N47°E 79.56'
Fd. 13" W.Oak S52°E 73.00'

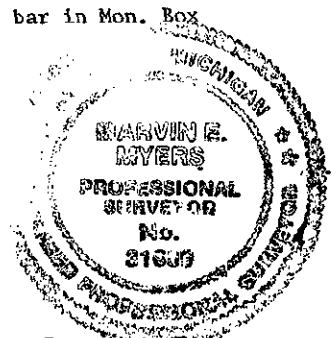

Signed by Marvin E. Myers

Date Dec 29, 1994

Surveyor's Michigan License No. 31600