

SURVEY & REMONUMENTATION

APR 07 1998

LAND CORNER RECORDATION CERTIFICATE
Filing Requirement of Act 74, Mich P.A. 1970

SECTION

For corners in
Crawford County

LIBER

3

PAGE 271

Located in:

Corner Code #

1. Public Land Survey

T26N R3W
T25N R3W
T R
T R

D-13 ✓
D-1

STATE OF MICHIGAN
COUNTY OF CRAWFORD

FILED FOR RECORD THIS
20 DAY OF Nov, 1997 AT
9:30 am, IN LIBER 3 of LC
PAGE 271
Sandra Moore
Register of Deeds

Register of Deeds Stamp & File Number

	A	B	C	D	E	F	G	H	I	J	K	L	M
2	6	5	4	3	2	1							
3													
4	7	8	9	10	11	12							
5													
6	18	17	16	15	14	13							
7													
8	19	20	21	22	23	24							
9													
10	30	29	28	27	26	25							
11													
12	31	32	33	34	35	36							
13													

I, Larry L. Cavanagh, in a field survey September, 1997, do hereby certify that under requirements of P.A. 74, Michigan P.A. of 1970, the corner points mentioned in line 1 above was in conformance with regulations and rules therefore as required in the current manual of survey instructions of the United States Department of the Interior, Bureau of Land Management or by a decree of a Court of Law; established, re-established, monumented, recovered, found as expressed below:

A. Description of original monument and accessories and/or subsequent restoration:

ADDISON P. BREWER 1852 SET POST PINE 4" N59°W 27' PINE 4" N29°E 62'	JAMES L. SCHWANDT 26466 FD LG SPIKE CENTER 4 MILE RD. FD. SPIKE QUAD 6" OAK S25°E 69.80' FD SPIKE 12" J. PINE S60°W 83.82' SET TAG 6" J. PINE NORTH 51.85' SET TAG 8" J. PINE N30°E 55.39'
KENNETH J. OSTLING 10068 1974 1" IRON BAR BY MDSH NO WITNESSES	MARVIN E. MYERS 31600 LCRC L3 P38 1991 SPIKE IN ASPHALT N-S UTILITY LINE EAST 103± FD NAIL & RLS TAG 26466 IN W. FACE 10" PINE N35°E 54.50 FD NAIL & RLS TAG 26466 IN W. FACE 8" PINE N00°E 51.87 NAIL & MDOT TAG NW FACE 14" PINE S65°W 83.63 NAIL NE FACE 8" OAK S50°E 72.05
OWEN AYRES & ASSOC INC. 1980 L185 P614 FD CONCRETE NAIL IN PAVT S35°E 69.79' NAIL & TAG IN W'LY OAK IN CLUMP N60°E 83.88' NAIL & TAG IN 15" JACKPINE ON CENTERLINE OF PAVT EAST & WEST	MARVIN E. MYERS 31600 FD SPIKE WIT. N-S 46 KV LINE EAST 103 NAIL & TAG 10" PINE N35°E 54.40' NAIL & TAG 8" PINE N0°E 51.87' NAIL & TAG 14" PINE S65°W 83.63' NAIL & TAG 8" OAK S50°E 72.05'

B. Description of corner evidence found and/or method applied in restoring or reestablishing corner:

FOUND 1/2" X 18" STEEL ROD CAPPED 31600 MEM
FOUND 10" PINE N35°E 54.40'
8" PINE N0°E 51.87'
14" PINE S65°W 83.63'
8" OAK S50°E 72.05'


C. Description of monument for corner and accessories established to perpetuate locating the position of the corner:

SET CRAWFORD COUNTY MONUMENT STAMPED 17614 1997
NAIL & TAG IN 10" J. PINE N35°E 55.24'
NAIL & TAG IN 8" J. PINE N13°W 48.34'
NAIL & TAG IN 20" J. PINE S65°W 83.70'
NAIL & TAG IN 8" B. OAK S50°E 72.07'
CARSONITE POST NORTH 31.4'

**CRAWFORD COUNTY
PEER GROUP APPROVAL
DATE** OCT 16, 1997

Marvin E. Myers
**Marvin E. Myers, P.S.
County Surveyor**

THE BEST AVAILABLE EVIDENCE OF THE POSITION OF THE ORIGINAL CORNER.

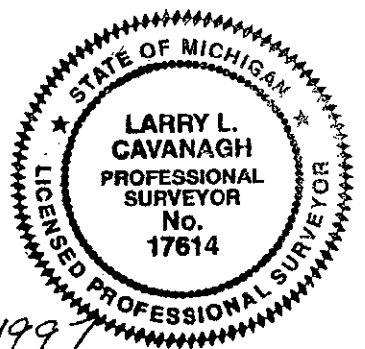

Signed by *Larry L. Cavanagh*
Surveyor's Michigan License NO. 17614

Date Oct. 22, 1997