

APR 07 1998

SECTION

LAND CORNER RECORDATION CERTIFICATE

Filing Requirement of Act 74, Mich P.A. 1970

STATE OF MICHIGAN

COUNTY OF CRAWFORD

For corners in Crawford County


LIBER

3 PAGE 272

Located in:

Corner Code #

I. Public Land Survey

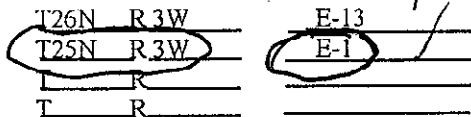

FILED FOR RECORD THIS

20 DAY OF Nov, 1997 AT

9:30 am, IN LIBER 3 of W

PAGE 272

Sandra Moore

Register of Deeds

Register of Deeds Stamp & File Number

I, Larry L. Cavanagh, in a field survey September, 1997, do hereby certify that under requirements of P.A. 74, Michigan P.A. of 1970, the corner points mentioned in line 1 above was in conformance with regulations and rules therefore as required in the current manual of survey instructions of the United States Department of the Interior, Bureau of Land Management or by a decree of a Court of Law; established, re-established, monumented, recovered, found as expressed below:

A. Description of original monument and accessories and/or subsequent restoration:

ADDISON B. BREWER 1852
PINE 10 N75 1/2 W 20
DO 8 N35E 58

CARL E. SHANGRAW 25872, 1990
WIT: PK IN NW SIDE 10" J. PINE S30°W 64.48'
PK IN S SIDE C.P. POLE N75°W 99.53'
NAIL IN SW SIDE 14" OAK N65°W 78.10'
NAIL IN W SIDE 8" J. PINE N15°E 50.52'

KENNETH J. OSTLING 10068
LCRC LI P 163 1971
SET 1" X 24" PIPE
16" OAK S20°W 93.4'
14" OAK N57°W 77.5'
5" J. PINE N4°W 49.8'

JAMES L. SCHWANDT 26466
FD 1 1/4" PIPE
SET TAG 8" J PINE 64.31 S15°W
FD SPK DNR POST N05°E 32.88'
FD TAG 4" J. PINE N05°W 49.78'
FD SPK 12" OAK N45°W 78.0'

OWEN AYRES & ASSOC., INC.
L 185 P 612 1980
FD 1 1/4" PIPE IN PAVT
S35°W N & T IN 9" JACK PINE 64.42'
N50°W N & T IN 14" OAK 78.08'
N 4°E N & T IN DNR WITNESS POST 32.89'

MARVIN E. MYERS 31600 LCRC L3 P 38 1991
1 1/2 PIPE
WIT: PK IN W. FACE 12" PINE S25°W 64.50'
NAIL IN W. FACE 12" PINE 63.73
NAIL IN E. FACE 14" OAK N60°W 77.55'
NAIL & RLS TAG #26446 E FACE PINE N05°W

OWEN AYRES & ASSOC., INC.
L 218 P 400 1983
FD 1 1/4" PIPE IN PAVT
S 35°W 64.42' N & T IN 6" JACK PINE
N50°W 78.08' N & T IN 14" OAK
N04°E 32.89' N & T IN DNR WITNESS POST

	A	B	C	D	E	F	G	H	I	J	K	L	M
2	6	5	4	3	2	1							
3													
4	7	8	9	10	11	12							
5													
6	18	17	16	15	14	13							
7													
8	19	20	21	22	23	24							
9													
10	30	29	28	27	26	25							
11													
12	31	32	33	34	35	36							
13													

MARVIN E. MYERS 31600
FD 1 1/2" PIPE
PK IN W SIDE 12" PINE S25°W 64.50
NAIL IN W SIDE 12" PINE N40°E 53.73'
NAIL IN E SIDE 14" OAK N60°W 77.55'
NAIL & LS TAG #26446 IN E SIDE 6" PINE
NW 49.8'

B. Description of corner evidence found and/or method applied in restoring or reestablishing corner:

FD 1" X 24" PIPE OVER LARGE IRON OBJECT, POSSIBLY A PIPE, COULD NOT REMOVE
PK IN W SIDE OF 12" PINE S25°W 64.50'
NAIL IN E SIDE 14" OAK N60°W 77.55'

C. Description of monument for corner and accessories established to perpetuate locating the position of the corner:

SET CRAWFORD COUNTY MONUMENT STAMPED 17614, 1997
NAIL & TAG IN 18" B OAK N60°W 77.45'
NAIL & TAG IN 12" J. PINE S25°W 64.23'
*NAIL & TAG IN 13" SCOTCH PINE N45°E 63.55'
*NAIL & TAG IN 6" CHERRY S10°E 78.0'
CARSONITE POST NORTH 31.8'

*NEW WITNESSES

CRAWFORD COUNTY
PEER GROUP APPROVAL
DATE OCT 16, 1997

Marvin E. Myers, P.S.
County Surveyor

THE BEST AVAILABLE EVIDENCE OF THE POSITION OF THE ORIGINAL CORNER.



Signed by *Larry L. Cavanagh*
Surveyor's Michigan License NO. 17614

Date Oct. 22, 1997