

APR 27 1995

CRAWFORD COUNTY
PEER GROUP APPROVAL
DATE Dec 22, 1994

LIBER 3 PAGE 149
LAND CORNER RECORDATION CERTIFICATE
Filing Requirement of Act 74, Mich. P.A. 1970

COMMISSION

For corners in

Crawford (County)	Located In:	Corner Code #
1. Public Land Survey	T 25N R 3W	E - 10
	T _____ R _____	_____
	T _____ R _____	_____
	T _____ R _____	_____
2. Property Controlling in Section	S _____ T _____ R _____	_____
	S _____ T _____ R _____	_____
3. Miscellaneous Property in Sec.	S _____ T _____ R _____	_____
	S _____ T _____ R _____	_____
4. Lot No. _____, Recorded Plat _____		
5. Private Claims _____		

STATE OF MICHIGAN
COUNTY OF CRAWFORD

FILED FOR RECORD THIS
30th DAY OF Dec, 1994 AT
4:20 am (pm) IN LIBER 3
PAGE 149.

Elisha W. Wiland
Register of Deeds, Stamp & File Number
Register of Deeds

I, Marvin E. Myers, in a field survey on December 7, 19 94, do hereby certify that under requirements of P.A. 74, Michigan P.A. of 1970, the corner points mentioned in lines 1 and 2 above were in conformance with regulations and rules therefore as required in the current manual of survey instructions of the United States Department of the Interior, Bureau of Land Management or by a decree of a Court of Law and/or that the corner points mentioned in lines 3, 4 and 5 above were in conformance with the rules of the Michigan Board of Land Surveyors or by a Decree of a Court of Law; established, re-established, monumented, re-monumented, recovered, found as expressed below:

	A	B	C	D	E	F	G	H	I	J	K	L	M
2	6		5		4		3		2				
3													
4	7		8		9		10		11		12		
5													
6	18		17		16		15		14		13		
7													
8	19		20		21		22		23		24		
9													
10	30		29		28		27		26		25		
11													
12	31		32		33		34		35		36		
13													

NOTE: Not more than 4 corners, all in the same town and range, may be recorded on this certificate.

A. Description of original monument and accessories and/or subsequent restoration:

GLO-A.P. Brewer Mon-Set Post WIT: 9" S.Pine N50°E 13 lks. 6" S.Pine S41°W 11 lks.	N. Parker Apr. 10, 1974 L.2, pg. 74 LCRC Mon-Fd. 1/2" Bar WIT: Set 1/2" Bar N89°35'W 33.0'
G.Henning May 1944 Mon-1"x24" Iron Pipe WIT: Mkd. B.T. 12" Cherry E. 102.3' Mkd. B.T. 16" B.Oak S19 1/2°W 101.7'	N. Parker Apr. 10, 1974 L.134, pg.423 Mon-1/2"x18" Iron Bar WIT: None
R.Ostling date unknown Mon-1" Pipe WIT: None	N. Parker Apr. 10, 1974 L.177, pg.564 Mon-Fd. 1/2" Bar WIT: Set 1/2" Bar N89°35'W 33.0'
N. Parker Oct. 14, 1969 Mon-Set 1/2"x18" Bar L.207, pg.80 WIT: Set 1/2"x18" Bar W. 33'	

G. Henning Sept. 21, 1976 L.161, pg.334
Mon-1" Pipe
WIT: 12" Cherry E. 102.3'
16" B.Oak S19 1/2°W 98.7'

F. Arleth June 9, 1977 L.295, pg.245
Mon-1"x24" Pipe
WIT: 12" T.B.Cherry E. 102.3'
16" B.Oak S19 1/2°W 101.7'


M.E. Myers 1993
Mon-Fd. 1" Iron Bar centerline Rd.
WIT: 1/2" Bar N84°W 28.5'
SE cor. metal fence post S. of fence intersection S53°W 44.4'
"X" chisled in S. side of rock S89°E 30.8'
S. cor. large metal fence post N35°E 72.2'

B. Description of corner evidence found and/or method applied in restoring or reestablishing corner:

Monument - Found 1" x 24" iron pinch pipe 6.0'± East of centerline of road
WIT: Fd. 1/2" iron bar N86°W 33.13'
Fd. SE cor. of metal fence post S. of fence int. S49°W 48.44'
NW face S'ly 4" metal gate post S35°E 43.80'
Accepted as the best available evidence of the position of the original corner.

C. Description of monument for corner and accessories established to perpetuate locating the position of the corner:

Mon-Set std. Crawford County Mon. stamped "T25N R3W E-10 31600" in exact location of found 1" pipe
WIT: Fd. 1/2" iron bar N86°W 33.13'
Set wit. tag & nail N. side 6" wood fence post S84°E 28.44'
Set wit. tag & nail E. side 6" B.Oak growing from large old stump S26°W 97.41'
Fd. SE cor. of metal fence post S. of fence intersection S49°W 48.44'
NW face S'ly 4" metal gate post S35°E 43.80'

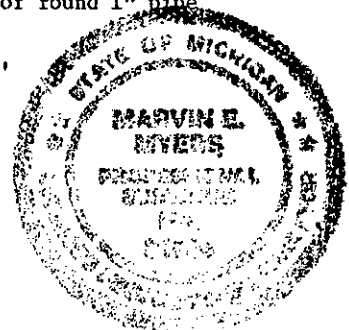

Signed by Marvin E. Myers
Surveyor's Michigan License No. 31600

Date DEC 29, 1994