

APR 27 1995

CRAWFORD COUNTY
PEER GROUP APPROVAL
DATE Dec 29, 1994

LIBER 3 PAGE 144

COMMISSION

LAND CORNER RECORDATION CERTIFICATE
Filing Requirement of Act 74, Mich. P.A. 1970

STATE OF MICHIGAN
COUNTY OF CRAWFORD

For corners in

Crawford (County)	Located in:	Corner Code #
1. Public Land Survey	T 25N R 3W	E - 12
	T _____ R _____	_____
	T _____ R _____	_____
	T _____ R _____	_____
2. Property Controlling in Section	S _____ T _____ R _____	_____
	S _____ T _____ R _____	_____
3. Miscellaneous Property in Sec.	S _____ T _____ R _____	_____
	S _____ T _____ R _____	_____

FILED FOR RECORD THIS
30th DAY OF Dec, 1994 AT
4:30 am/pm IN LIBER 3 4c
PAGE 144

Elizabeth W. Wiland
Register of Deeds

Register of Deeds Stamp & File Number

- 4. Lot No. _____, Recorded Plat _____
- 5. Private Claims _____

	A	B	C	D	E	F	G	H	I	J	K	L	M
2	6	5	4	3	2	1							
3													
4	7	8	9	10	11	12							
5													
6	18	17	16	15	14	13							
7													
8	19	20	21	22	23	24							
9													
10	30	29	28	27	26	25							
11													
12	31	32	33	34	35	36							
13													

I, Marvin E. Myers, in a field survey on December 14, 19 94, do hereby certify that under requirements of P.A. 74, Michigan P.A. of 1970, the corner points mentioned in lines 1 and 2 above were in conformance with regulations and rules therefore as required in the current manual of survey instructions of the United States Department of the Interior, Bureau of Land Management or by a decree of a Court of Law and/or that the corner points mentioned in lines 3, 4 and 5 above were in conformance with the rules of the Michigan Board of Land Surveyors or by a Decree of a Court of Law; established, re-established, monumented, re-monumented, recovered, found as expressed below:

NOTE: Not more than 4 corners, all in the same town and range, may be recorded on this certificate.

A. Description of original monument and accessories and/or subsequent restoration:

GLO-A.P. Brewer 1852
Mon-Set Post
WIT: 10" S.Pine S17°E 226 lks.
8" S.Pine N07°W 79 lks.

N. Parker Mar. 27, 1973 L.2, pg. 75 LCRC
Mon-1/2" bar
WIT: NBT 9" N.Pine N23°W 57.1'
NBT 10" J.Pine N53 1/2°E 69.0'

R. Ostling June 11, 1954
Mon-MSHD pav't box 1' West of C_L
WIT: None

B. Description of corner evidence found and/or method applied in restoring or reestablishing corner:

Monument - Found R.R. spike at surface 0.56' North and 0.12' East of found 1 1/2" x 22" iron rod 2' below surface 3' North of centerline Dort Road and 2' West of centerline Grayling Road.


WIT: Fd. G. Henning wit. tag & nail SW side 14" J.Pine N34°W 71.4'
Fd. G. Henning wit. tag & nail SE side 17" R.Pine S45°W 98.21'

Accepted as the best available evidence of the position of the Original Corner.

C. Description of monument for corner and accessories established to perpetuate locating the position of the corner:

Mon-Set std. Crawford County Mon. stamped "T25N R3W E-12 31600" in mon. box in exact location of 1 1/2" x 1 1/2" x 22" iron rod

WIT: Fd. G. Henning wit. tag & nail SW side 14" J.Pine N34°W 71.4'
Set wit. tag & nail SE side 9" J.Pine N36°E 59.20'
Set wit. tag & nail S. side U.Pole S67°E 33.19'
Fd. G. Henning wit. tag & nail SE side 17" R.Pine S45°W 98.21'

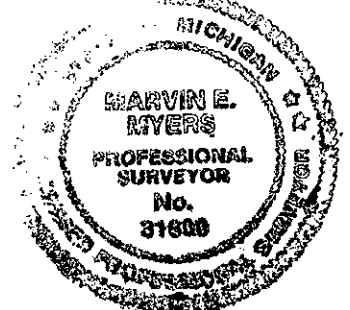

Signed by Marvin E. Myers
Surveyor's Michigan License No. 31600

Date Dec 29, 1994