

SURVEY & REMONUMENTATION

APR 07 1998

SECTION

LAND CORNER RECORDATION CERTIFICATE
 Filing Requirement of Act 74, Mich P.A. 1970


LIBER 3 PAGE 273

For corners in
 Crawford County

STATE OF MICHIGAN
 COUNTY OF CRAWFORD

1. Public Land Survey

Located in: Corner Code #

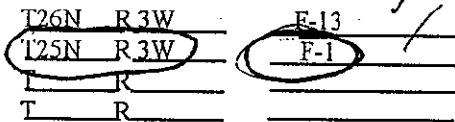

FILED FOR RECORD THIS
 20 DAY OF Nov, 1997 AT
 9:30 am/pm, IN LIBER 3 OF L
 PAGE 273.

Sandra Moore

Register of Deeds

Register of Deeds Stamp & File Number

I, Larry L. Cavanagh, in a field survey September, 1997, do hereby certify that under requirements of P.A. 74, Michigan P.A. of 1970, the corner points mentioned in line 1 above was in conformance with regulations and rules therefore as required in the current manual of survey instructions of the United States Department of the Interior, Bureau of Land Management or by a decree of a Court of Law; established, re-established, monumented, recovered, found as expressed below:

A. Description of original monument and accessories and/or subsequent restoration:

ADDISON P. BREWER 1852
 SET POST
 PINE 10 N86W 34
 DO 4 N60 1/2E 46

OWEN AYRES & ASSOC., INC. 1980
 L185 P614
 FD 1 1/4" PIPE IN PAVT
 S25°W NAIL & TAG IN 8" OAK 57.14'
 SOUTH NAIL & TAG IN 10" OAK 65.78'
 ON CENTERLINE OF PAVT. EAST AND WEST

KENNETH J. OSTLING 10068
 1971 LCRC LI P 161
 SET 1" X 2' PIPE
 8" WHITE OAK S34W 80.9
 9" WHITE OAK N25W 93.8

OWEN AYRES & ASSOC., INC. 1980
 L215 P 400
 FD 1 1/4" PIPE IN PAVT
 S25°W 57.14' NAIL & TAG IN 8" OAK
 SOUTH 65.78' NAIL & TAG IN 10" OAK
 CORNER IS ON CENTERLINE OF PAVT EAST AND WEST

	A	B	C	D	E	F	G	H	I	J	K	L	M
2	6	5	4	3	2	1							
3													
4	7	8	9	10	11	12							
5													
6	18	17	16	15	14	13							
7													
8	19	20	21	22	23	24							
9													
10	30	29	28	27	26	25							
11													
12	31	32	33	34	35	36							
13													

B. Description of corner evidence found and/or method applied in restoring or reestablishing corner:

FOUND 1" X 27" PIPE
 SOUTH 65.78' NAIL & TAG IN 10" OAK


C. Description of monument for corner and accessories established to perpetuate locating the position of the corner:

SET CRAWFORD COUNTY MONUMENT STAMPED 17614, 1997
 NAIL & TAG IN 5" S PINE S30°W 45.07'
 NAIL & TAG IN 12" R OAK S56W 65.83'
 NAIL & TAG IN 12" W OAK N25°W 94.40'
 NAIL & TAG IN 7" R. OAK N25°E 59.21'
 CARSONITE POST NORTH 25.7'

A REESTABLISHMENT OF THE POSITION OF THE ORIGINAL GOVERNMENT CORNER.

CRAWFORD COUNTY
PEER GROUP APPROVAL
 DATE OCT 16, 1997

Marvin E. Myers
 Marvin E. Myers, P.S.
 County Surveyor

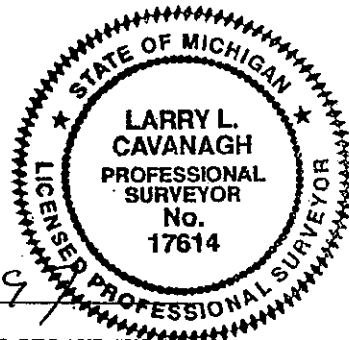

Signed by *Larry L. Cavanagh*
 Surveyor's Michigan License NO. 17614

Date Oct. 22, 1997