

APR 07 1998

SECTION

LAND CORNER RECORDATION CERTIFICATE
Filing Requirement of Act 74, Mich P.A. 1970

For corners in
Crawford County

LIBER 3 PAGE 274

Located in: Corner Code #

1. Public Land Survey

T26N	R3W	G-13
<u>T25N</u>	<u>R3W</u>	<u>G-1</u>
T	R	
T	R	

STATE OF MICHIGAN
COUNTY OF CRAWFORD

FILED FOR RECORD THIS
20 DAY OF Nov, 1997 AT
9:30 am. IN LIBER 3 of LC
PAGE 274.

Sandra Moore
Register of Deeds

Register of Deeds Stamp & File Number

I, Larry L. Cavanagh, in a field survey September, 1997, do hereby certify that under requirements of P.A. 74, Michigan P.A. of 1970, the corner points mentioned in line 1 above was in conformance with regulations and rules therefore as required in the current manual of survey instructions of the United States Department of the Interior, Bureau of Land Management or by a decree of a Court of Law; established, re-established, monumented, recovered, found as expressed below:

A. Description of original monument and accessories and/or subsequent restoration:

ADDITION P. BREWER 1954
A CEDAR 12 FOR CORNER
NO WITNESSES

KENNETH J. OSTLING 10068 1974
LCRC
1" PIPE CENTERLINE 4 MILE RD
REWITNESS 5" R. PINE S9°W 95.5'
FACE OF P. POLE S43°E 51.5'
FACE OF GUY POLE N51°E 49.25'

KENNETH J. OSTLING 10068 1854
DNR SURVEY
FD PIPE PREVIOUS SURVEY
NO WITNESSES

OWEN AYRES & ASSOC., INC.
1980 L185 P614
FD 1 1/4" PIPE UNDER PAVT
N45°E NAIL & TAG IN GUY POLE 49.54'
N45°W CENTERLINE 3" WELL CASING 52.03'
S50°W NAIL & TAG IN P.P. 51.81' ON
CENTERLINE ROAD EAST AND WEST

KENNETH OSTLING 10068 1971
LCRC L1 P162
FD 1/2 BAR REPLACE WITH 1"X 2' PIPE
10" OAK N56°W 66.9'
2" PIPE N35°W 52.0'
12" J. PINE N14°E 55.1'

OWEN AYRES & ASSOC., INC.
1983 L215 P400
FD 1 1/4" PIPE UNDER PAVT
SAME WITNESSES AS ABOVE

B. Description of corner evidence found and/or method applied in restoring or reestablishing corner:

FD 1" PIPE 28" LONG WITH 1/2 BAR IN BOTTOM
N45°E NAIL & TAG IN GUY PPOLE 49.54'
N45°W 52.03' CENTERLINE 3" WELL CASING
S50°E 51.81' NAIL & TAG IN POWER POLE

C. Description of monument for corner and accessories established to perpetuate locating the position of the corner:


SET CRAWFORD COUNTY MONUMENT STAMPED 17614, 1997
*NAIL & TAG IN P. POLE S40°W 48.35'
NAIL & TAG IN P. POLE S50°E 51.78'
NAIL & TAG IN GUY POLE N45°E 49.58'
NAIL & TAG IN CENTER OF 3" WELL CASING N36°W 52.05'
CARSONITE POST N5°E 35.4'

*NEW WITNESSES

THE BEST AVAILABLE EVIDENCE OF THE POSITION OF THE ORIGINAL CORNER.

CRAWFORD COUNTY
PEER GROUP APPROVAL
DATE Oct 16, 1997

Marvin E. Myers
Marvin E. Myers, P.S.
County Surveyor

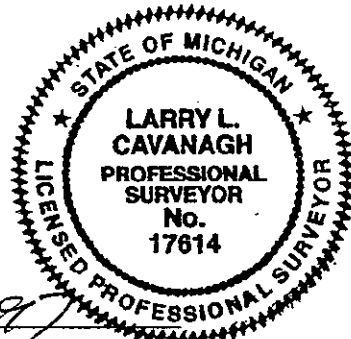

Signed by *Larry L. Cavanagh*
Surveyor's Michigan License NO. 17614

Date Oct. 22, 1997