

SURVEY & REMONUMENTATION

APR 07 1998

LAND CORNER RECORDATION CERTIFICATE
Filing Requirement of Act 74, Mich P.A. 1970

SECTION

For corners in
Crawford County


LIBER

3 PAGE 276

STATE OF MICHIGAN
COUNTY OF CRAWFORD

Located in: Corner Code #

I. Public Land Survey

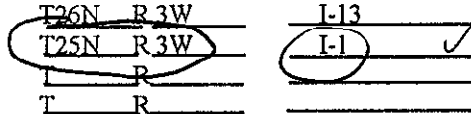

FILED FOR RECORD THIS
30 DAY OF Nov, 1997 AT
9:30 am/pm. IN LIBER 3 OF LC
PAGE 276
Sandra Moore
Register of Deeds

Register of Deeds Stamp & File Number

I, Larry L. Cavanagh, in a field survey September, 1997, do hereby certify that under requirements of P.A. 74, Michigan P.A. of 1970, the corner points mentioned in line 1 above was in conformance with regulations and rules therefore as required in the current manual of survey instructions of the United States Department of the Interior, Bureau of Land Management or by a decree of a Court of Law; established, re-established, monumented, recovered, found as expressed below:

	A	B	C	D	E	F	G	H	I	J	K	L	M
2	6	5	4	3	2	1							
3													
4	7	8	9	10	11	12							
5													
6	18	17	16	15	14	13							
7													
8	19	20	21	22	23	24							
9													
10	30	29	28	27	26	25							
11													
12	31	32	33	34	35	36							
13													

A. Description of original monument and accessories and/or subsequent restoration:

- ADDISON P. BREWER SET POST PINE N80°W 22 PINE N34°E 20
- KENNETH J. OSTLING 1954 FD PIPE BY PREVIOUS SURVEY NO WITNESSES
- NORMAN F. PARKER 16939 L139 P480 1974 FD 1/2 IRON BAR N88°W 79.9 10" J. PINE N45°E 91.8' 6" J. PINE N54°W 65.W' 10" J. PINE S44°W 47.7' 5" J. PINE
- NORMAN F. PARKER 16939 L162 P399 1977 OLD J. PINE STUMP N40°W 48.4' OLD 6" J. PINE N45°E 91.8'
- GEORGE D. HENNING 2240 L180 P513 1979 FD 1/2" BAR 10" J. PINE N32°W 79.9' 6" J. PINE N43°E 91.8' 10" J. PINE S36°W 63.2' 5" J. PINE S44°30'E 90.7'
- JOHN I NELSON 21273 L2 P246 1982 SET NAIL W/RLS TAG 21273 IN WEST SIDE OF P. POLE AZ 22° 36.88' SET NAIL W/RLS TAG 21273 IN NE SIDE OF 6" OAK AZ 157° 44.32' SET NAIL W/RLS TAG 21273 IN NW SIDE OF 8" OAK AZ 230°125.20' SET NAIL W/RLS TAG 21273 IN EAST SIDE OF 6" OAK AZ 355° 108.83'

B. Description of corner evidence found and/or method applied in restoring or reestablishing corner:

FD 1/2" X18" STEEL BAR OVER 1" PIPE
NAIL W/RLS TAG 21273 IN WEST SIDE OF P. POLE AZ 22° 36.89'


C. Description of monument for corner and accessories established to perpetuate locating the position of the corner:

- SET CRAWFORD COUNTY MONUMENT STAMPED 17614 1997
- *NAIL & TAG IN 10" J. PINE N43°E 91.95'
- NAIL & TAG IN P. POLE N19°E 36.87'
- *NAIL & TAG IN 7" J. PINE N23°W 58.70'
- *NAIL & TAG IN 14" J. PINE S28°W 98.66'
- NAIL & TAG IN 10" N. PINE S65°E 89.45'
- CARSONITE POST N40°E 44.25'
- *NEW WITNESSES

CRAWFORD COUNTY
PEER GROUP APPROVAL
DATE Oct 16, 1997

Marvin E. Myers
Marvin E. Myers, P.S.
County Surveyor

THE BEST AVAILABLE EVIDENCE OF THE POSITION OF THE ORIGINAL CORNER.

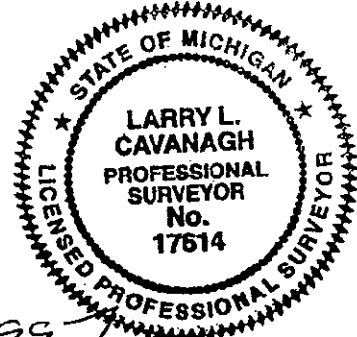

Signed by *Larry L. Cavanagh* Date Oct. 22, 1997
Surveyor's Michigan License NO. 17614