

MAR 22 1999

LIBER 3 PAGE 326

LAND CORNER RECORDATION CERTIFICATE
Filing Requirement of Act 74, Mich P.A. 1970

SECTION

For corners in
Crawford County

Located in: Corner Code #

1. Public Land Survey

T25N R3W K-7
T R
T R
T R

STATE OF MICHIGAN
CRAWFORD COUNTY
RECORDED

29 SEP 98 10:00 A.M.

SANDRA MOORE
REGISTER OF DEEDS

Register of Deeds Stamp & File Number

I, Larry L. Cavanagh, in a field survey August, 1998, do hereby certify that under requirements of P.A. 74, Michigan P.A. of 1970, the corner points mentioned in line 1 above was in conformance with regulations and rules therefore as required in the current manual of survey instructions of the United States Department of the Interior, Bureau of Land Management or by a decree of a Court of Law; established, re-established, monumented, recovered, found as expressed below:

A. Description of original monument and accessories and/or subsequent restoration:

A.P. BREWER 1852, GLO
SET POST
W. PINE 7° N49°W 16 LKS
W. PINE 30° S48°E 37 LKS

D.C. DELAMATERRLS 1954

LCRC L5, P17
MON - 1" PIPE WITH 4" BRASS
CAP

(ESTABLISHED BY SINGLE PROP
DIST. ONE PROB. ORIGINAL
B.T. STILL IN PLACE, BADLY BURNED)

9" R. OAK N28°E 31 LKS
7" W.OAK S25°E 61 LKS

Grid table with columns A-M and rows 1-12. Contains numbers 1-36 in a grid pattern.

B. Description of corner evidence found and/or method applied in restoring or reestablishing corner:

FOUND DNR MONUMENT IN PLACE AND REMAINS OF OAK STUMP SE 40.26'


A PERPETUATION OF THE ORIGINAL GOVERNMENT CORNER.

C. Description of monument for corner and accessories established to perpetuate locating the position of the corner:

LEFT DNR MONUMENT IN PLACE
WIT: NAIL & TAG IN 9" R. OAK (PREVIOUS BLAZE) N19°E 36.42'
NAIL & TAG IN 8" R. OAK N70°E 7.54'
NAIL & TAG IN 5" MAPLE S10°W 13.40'
NAIL & TAG IN 7" MAPLE N80°W 17.09'
CARSONITE POST SOUTH 1.0'

CRAWFORD COUNTY
PEER GROUP APPROVAL
DATE Aug 21, 1998

Marvin E. Myers, P.S.
County Surveyor

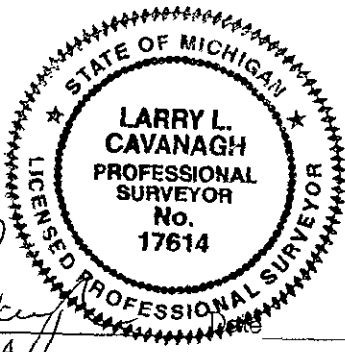

Signed by [Signature]
Surveyor's Michigan License NO. 17614

8-24-98