

**SURVEY &
REMONUMENTATION**

APR 07 1998

SECTION


LAND CORNER RECORDATION CERTIFICATE
Filing Requirement of Act 74, Mich P.A. 1970

For corners in
Crawford County

LIBER 3 PAGE 279

Located in: Corner Code #

1. Public Land Survey

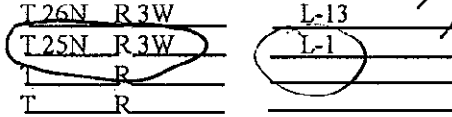

STATE OF MICHIGAN
COUNTY OF CRAWFORD

FILED FOR RECORD THIS
20 DAY OF NOV. 1997 AT
9:30 AM IN LIBER 3 of LL
PAGE 279

Sandra Moore
Register of Deeds

Register of Deeds Stamp & File Number

I, Larry L. Cavanagh, in a field survey September, 1997, do hereby certify that under requirements of P.A. 74, Michigan P.A. of 1970, the corner points mentioned in line 1 above was in conformance with regulations and rules therefore as required in the current manual of survey instructions of the United States Department of the Interior, Bureau of Land Management or by a decree of a Court of Law; established, re-established, monumented, recovered, found as expressed below:

A. Description of original monument and accessories and/or subsequent restoration:

ADDISON P. BREWER 1852	KENNETH J. OSTLING 10068
SET POST	L2 P215 1979
PINE 8 N25W 10	FD RR RAIL
PINE 6 N62E 22	6" J PINE S38°W 27.62'
	P.K. IN P.P. S41°E 22.84'
GENE OSTLING 1968-69	5" J PINE S33°E 22.95'
FD RAILROAD NAIL	CEDAR POST SOUTH 19'
NO WITNESSES	



	A	B	C	D	E	F	G	H	I	J	K	L	M
2	6		5		4		3		2		1		
3													
4	7		8		9		10		11		12		
5													
6	18		17		16		15		14		13		
7													
8	19		20		21		22		23		24		
9													
10	30		29		28		27		26		25		
11													
12	31		32		33		34		35		36		
13													

B. Description of corner evidence found and/or method applied in restoring or reestablishing corner:

NO CORNER MATERIAL FOUND
THESE WITNESSES FOUND AND USED TO RE-SET MONUMENT
6" J. PINE S38°W 27.61'
P.K. IN P.P. S41°E 22.84'
5" J PINE S33°E 22.95'

C. Description of monument for corner and accessories established to perpetuate locating the position of the corner:


SET CRAWFORD COUNTY MONUMENT STAMPED 17614 1997
NAIL & TAG IN P. POLE S41°E 22.72'
NAIL & TAG IN 9" J. PINE S38°W 27.63'
NAIL & TAG IN 9" J. PINE S33°E 23.06'
*NAIL & TAG IN 34" B. OAK N76°W 114.61'
1/2" BAR N02°E 34.41'
CARSONITE POST SOUTH 21.55'

*NEW WITNESSES

**CRAWFORD COUNTY
PEER GROUP APPROVAL
DATE OCT 16, 1997**

Marvin E. Myers
Marvin E. Myers, P.S.
County Surveyor

THE BEST AVAILABLE EVIDENCE OF THE POSITION OF THE ORIGINAL CORNER.

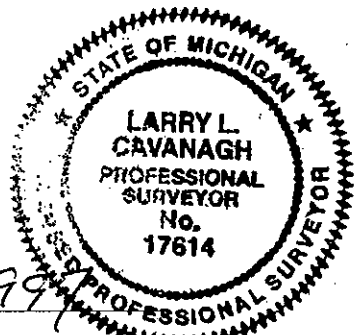

Signed by *Larry L. Cavanagh*
Surveyor's Michigan License NO. 17614

Date *Oct. 22, 1997*