

APR 22 1999

SECTION

LAND CORNER RECORDATION CERTIFICATE
Filing Requirement of Act 74, Mich P.A. 1970

For corners in
Crawford County

Located in: Corner Code #

1. Public Land Survey

T25N	R 3W	L-7
T	R	
T	R	
T	R	

STATE OF MICHIGAN
CRAWFORD COUNTY
RECORDED

29 SEP 78 10:00 A.M.

SANDRA MOORE
REGISTER OF DEEDS

Register of Deeds Stamp & File Number

I, Larry L. Cavanagh, in a field survey August, 1998, do hereby certify that under requirements of P.A. 74, Michigan P.A. of 1970, the corner points mentioned in line 1 above was in conformance with regulations and rules therefore as required in the current manual of survey instructions of the United States Department of the Interior, Bureau of Land Management or by a decree of a Court of Law; established, re-established, monumented, recovered, found as expressed below:

A	B	C	D	E	F	G	H	I	J	K	L	M
2	6	5	4	3	2	1						
3												
4	7	8	9	10	11	12						
5												
6	18	17	16	15	14	13						
7												
8	19	20	21	22	23	24						
9												
10	30	29	28	27	26	25						
11												
12	31	32	33	34	35	36						
13												

A. Description of original monument and accessories and/or subsequent restoration:

- A.P. BREWER 1852, GLO SET POST
- S. PINE 6" S18°W 20 LKS
- S. PINE 12" N50°E 32 LKS
- K.J. OSTLING, RLS 1954 DNR TOWNSHIP MAP INDICATES CORNER NOT FOUND SET
- D.C. DELAMATER, RLS 1956 LCRC L5, P18 MON 1" PIPE/BRASS COP SET BY SINGLE PROP. MEAS. 10" B. OAK N106°W 29 1/2 LKS 6" B. OAK S55°W 11 LKS
- C.R. JOHNSON, LS 1989 LCRC L2, P310 SET MIDWAY & ON LINE BTWN SEC. CORNS MON - DNR MON 6" J. PINE N11°W 18.7' 12" J. PINE N62°E 37.1' 8" R. OAK S30°E 32.2' 10" J. PINE S49°W 22.6'

B. Description of corner evidence found and/or method applied in restoring or reestablishing corner:

- FOUND DNR MONUMENT IN PLACE
- FOUND NW WITNESS (1989)
- FOUND SW WITNESS (1989)


A CAREFUL AND FAITHFUL ESTABLISHMENT OF THE POSITION OF THE CORNER.

C. Description of monument for corner and accessories established to perpetuate locating the position of the corner:

- LEFT DNR MONUMENT IN PLACE
- WIT: NAIL & TAG IN 2" OAK (GROWING OUT OF STUMP) S70°E 23.7'
- NAIL & TAG IN 4" OAK N55°E 37.19'
- NAIL & TAG IN 12" J. PINE S49°W 23.05'
- NAIL & TAG IN 8" J. PINE N11°W 19.15'
- CARSONITE POST WEST 1.1'

CRAWFORD COUNTY
PEER GROUP APPROVAL
DATE Aug 21, 1998

Marvin E. Myers
Marvin E. Myers, P.S.
County Surveyor

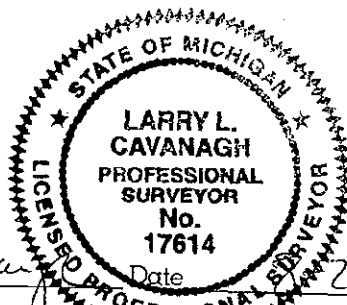

Signed by Larry L. Cavanagh
Surveyor's Michigan License NO. 17614

Date 24-98