

MAR 29 2000

SECTION

LAND CORNER RECORDATION CERTIFICATE
Filing Requirement of Act 74, Mich P.A. 1970

For corners in
Crawford County

LIBER

4 PAGE 43

STATE OF MICHIGAN
COUNTY OF CRAWFORD

Located in: Corner Code #

FILED FOR RECORD THIS
29th DAY OF Sept 1999 AT
9:00 am/pt. IN LIBER 4
PAGE 43
Andrea Moore
Register of Deeds

1. Public Land Survey T25N R3W L-13
T R
T R
T R

I, Larry L. Cavanagh, in a field survey July 1999, do hereby certify that under requirements of P.A. 74, Michigan P.A. of 1970, the corner points mentioned in line 1 above was in conformance with regulations and rules therefore as required in the current manual of survey instructions of the United States Department of the Interior, Bureau of Land Management or by a decree of a Court of Law; established, re-established, monumented, recovered, found as expressed below:

A. Description of original monument and accessories and/or subsequent restoration:

JOHN BRINK, GLO 1838 LARRY L. CAVANAGH PS, 1993
SET QR SEC POST NO MON MATERIAL MENTIONED
HEMLOCK 10' N13°W 27 LKS P. POLE S30°E 49.05'
BEECH7' S57°E 21 LKS 16' R. PINE N20°E 88.2'
15' N. PINE N30°W 85.64'
HENNING & OSTLING 1945 P. POLE S28°W 110.68'
IRON IN PAVT BOX 0.4' SOUTH
OF CENTERLINE OF PAVT
FRANK J. ARLETH, PS 1996
L745, P109
GEORGE D. HENNING, RLS 1953 PAVT BOX IN M-76
1/4 COR, MON BOX CENTERLINE SAME WITNESSES AS L357, P505
OF PAVT.
LARRY L. CAVANAGH, PS 1997
SAME WITNESSES AS 1993 SURVEY
FRANK J. ARLETH, RLS, 1978
SURVEY L357, P505
MON BOX IN M-76
P. POLE S30°E 49.05'
16' R. PINE N20°E 88.2'
LARRY L. CAVANAGH PS 1998
SAME WITNESSES AS ABOVE

Register of Deeds Stamp & File Number

	A	B	C	D	E	F	G	H	I	J	K	L	M
2	6		5		4		3		2		1		
3													
4	7		8		9		10		11		12		
5													
6	18		17		16		15		14		13		
7													
8	19		20		21		22		23		24		
9													
10	30		29		28		27		26		25		
11													
12	31		32		33		34		35		36		
13													

B. Description of corner evidence found and/or method applied in restoring or reestablishing corner:

FOUND PAVEMENT BOX. OVER PAVEMENT BOX 1' BELOW THE SURFACE, ON CENTERLINE OF M-76 1'± EAST OF THE CENTERLINE OF STEEL ROAD
NO MONUMENT IN BOX
FOUND 15' N PINE NW
FOUND 16' N PINE NE


THE BEST AVAILABLE EVIDENCE OF THE POSITION OF THE ORIGINAL CORNER.

C. Description of monument for corner and accessories established to perpetuate locating the position of the corner:

SET 1/2 OF STANDARD MONUMENT CEMENTED IN PLACE OVER TOP OF BOTTOM MONUMENT BOX
WIT: NAIL & TAG IN 17' N. PINE N20°E 88.63'
NAIL & TAG IN 16' N PINE N30°W 85.57'
NAIL & TAG IN P. POLE S23°W 110.59'
NAIL & TAG IN LIGHT POLE S26°E 55.71'
CARSONITE POST S50°W 56.7'

CRAWFORD COUNTY
PEER GROUP APPROVAL
DATE Sept 10, 1999

Marvin E. Myers
Marvin E. Myers, P.S.
County Surveyor

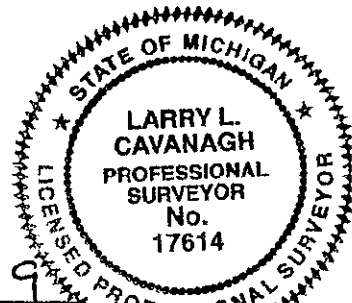

Signed by *Larry L. Cavanagh*
Surveyor's Michigan License NO. 17614

Date Sept 14, 1999