

SURVEY & REMONUMENTATION

APR 07 1998

SECTION

LAND CORNER RECORDATION CERTIFICATE
Filing Requirement of Act 74, Mich P.A. 1970

For corners in
Crawford County

LIBER

3 PAGE 280

STATE OF MICHIGAN
COUNTY OF CRAWFORD

FILED FOR RECORD THIS
20 DAY OF Nov, 1997 AT
9:30 am/pm, IN LIBER 3 OF LC
PAGE 280

Sandra Moore

Register of Deeds

Register of Deeds Stamp & File Number

1. Public Land Survey

Located in:	Corner Code #
T26N R3W	M-13
<u>T25N R3W</u>	<u>M-1</u> ✓
T25N R2W	A-1 ✓
T26N R2W	A-13 ✓

I, Larry L. Cavanagh, in a field survey September, 1997, do hereby certify that under requirements of P.A. 74, Michigan P.A. of 1970, the corner points mentioned in line 1 above was in conformance with regulations and rules therefore as required in the current manual of survey instructions of the United States Department of the Interior, Bureau of Land Management or by a decree of a Court of Law; established, re-established, monumented, recovered, found as expressed below:

A. Description of original monument and accessories and/or subsequent restoration:

SET ADDISON P. BREWER
SET POST
PINE 10 N30 1/2W 11
PINE 8 S48W 15

KENNETH J. OSTLING 10068 1979
FD 1/2" IRON BAR AT CORNER
BY HENNING, 1937
NO WITNESSES

ju

	A	B	C	D	E	F	G	H	I	J	K	L	M
2	6		5		4		3		2		1		
3													
4	7		8		9		10		11		12		
5													
6	18		17		16		15		14		13		
7													
8	19		20		21		22		23		24		
9													
10	30		29		28		27		26		25		
11													
12	31		32		33		34		35		36		
13													

B. Description of corner evidence found and/or method applied in restoring or reestablishing corner:

FD 1/2" BAR AND THE REMAINS OF AN OLD WOOD POST

C. Description of monument for corner and accessories established to perpetuate locating the position of the corner:

SET CRAWFORD COUNTY MONUMENT STAMPED 17614 1997
NAIL & TAG IN 7" J. PINE N29°W 66.93'
NAIL & TAG IN 9" J. PINE N26°E 30.15'
NAIL & TAG IN 8" J. PINE S13°E 41.03'
NAIL & TAG IN 9" J. PINE S55°W 32.16'
CARSONITE POST S12°W 21.10'

THE BEST AVAILABLE EVIDENCE OF THE POSITION OF THE ORIGINAL CORNER.


CRAWFORD COUNTY

PEER GROUP APPROVAL

DATE OCT 16, 1997

Marvin E. Myers

Marvin E. Myers, P.S.
County Surveyor

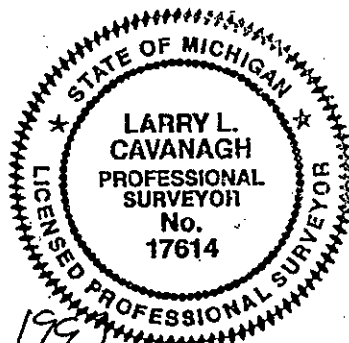

Signed by *Larry Cavanagh*
Surveyor's Michigan License NO. 17614

Date Oct 22, 1997