

MAR 22 1999

LIBER 3 PAGE 328

SECTION

LAND CORNER RECORDATION CERTIFICATE
Filing Requirement of Act 74, Mich. P.A. 1970

For corners in

Crawford
(County)

Located In:

Corner Code #

- 1. Public Land Survey T 25N R 3W
T 25N R 2W
T _____ R _____
T _____ R _____
- 2. Property Controlling S _____ T _____ R _____
in Section S _____ T _____ R _____
- 3. Miscellaneous S _____ T _____ R _____
Property in Sec. S _____ T _____ R _____

M-8
A-8

STATE OF MICHIGAN
CRAWFORD COUNTY
RECORDED

29 SEP 98 10:00 A.M.

SANDRA MOORE
REGISTER OF DEEDS

Register of Deeds Stamp & File Num

- 4. Lot No. _____, Recorded Plat _____
- 5. Private Claims _____

I, Marvin E. Myers, in a field survey on July 15, 1998 do hereby state that under requirements of P.A. 74, Michigan P.A. of 1970, the corner points mentioned in lines 1 and 2 above were in conformance with regulations and rules therefore as required in the current manual of survey instructions of the United States Department of the Interior, Bureau of Land Management or by a decree of a Court of Law and for that the corner points mentioned in lines 3, 4 and 5 above were in conformance with the rules of the Michigan Board of Land Surveyors or by a Decree of a Court of Law, established, re-established, monumented, recovered, found as expressed below:

	A	B	C	D	E	F	G	H	I	J	K	L
2	6		5		4		3		2		1	
3												
4	7		8		9		10		11		12	
5												
6	18		17		16		15		14		13	
7												
8	19		20		21		22		23		24	
9												
10	30		29		28		27		26		25	
11												
12	31		32		33		34		35		36	
13												

NOTE: Not more than 2 corners, all in the same town and range, may be recorded on this certificate.

A. Description of original monument and accessories and/or subsequent restoration:

- G.L.O - 1839 John Brink, DS Jan 15, 1990 Carl R. Johnson, P.S. 30083
Mon. - Post Mon - Set DNR Monument
8" Pine S65°W 25 lks.
8" Pine N73°W 21 lks.
- L3 P.25 Indian Glens of the AuSable #5 LCRC May 30, 1998 Carl R. Johnson, P.S. 30083 (not recorded)
Aug 1971 C.E. Ostling, #12026 Wit: 14" R. Oak N14°W 13.7
Mon - Not given 5" R. Oak N62°E 24.1
4" R. Oak S33°E 19.4

B. Description of corner evidence found and/or method applied in restoring or reestablishing corner:

Found DNR Monument of record. Found (dead) 4" R. Oak S33°E 19.4; found 14" R. Oak (wind blown down); found 5" R. Oak (wind blown down) Accepted DNR monument as a careful and faithful establishment of the position of the Corner.

C. Description of monument for corner and accessories established to perpetuate locating the position of the corner:


- Mon - DNR monument left in place.
- Wit: Set nail & tag W. side 12" Oak South 24.19
Set nail & tag S. side 14" Oak S79°W 52.52
Set nail & tag NE. side 3" Maple N49°W 47.94
Set nail & tag W. side 6" Oak N06°E 33.14
Set Carsonite Post West 1.0

CRAWFORD COUNTY
PEER GROUP APPROVAL

DATE Aug 21, 1998

Marvin E. Myers

Marvin E. Myers, P.S.
County Surveyor

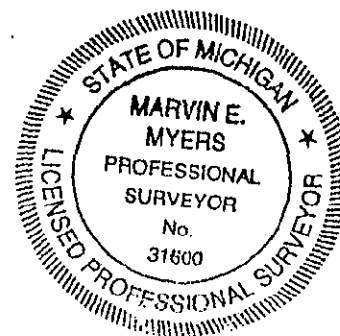

Signed by *Marvin E. Myers*

Date Aug 24, 1998

Surveyor's Michigan License No. 31600