

STATE OF MICHIGAN
DEPARTMENT
OF
NATURAL RESOURCES

LAND CORNER RECORD


CRAWFORD COUNTY
T 25 N R 3 W

DESCRIPTION OF CORNER Center corner, Section 11

CORNER MONUMENT Set 2' of 1" pipe

DATE MONUMENT PLACED AND WITNESSED 5-30-72

WITNESSES TO CORNER.....

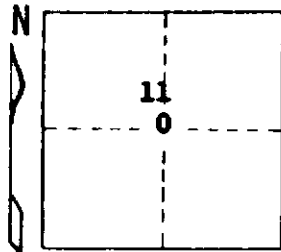

11" J. Pine S 15 E 77.8'


6" J. Pine N 68 E 102.1'

AND

CIRCLE CORNER REGISTERED

DESCRIPTION IN DETAIL AS TO HOW CORNER WAS LOCATED AND IDENTIFIED OR RESTORED.

This corner established at the true intersection of the 1/4 lines.

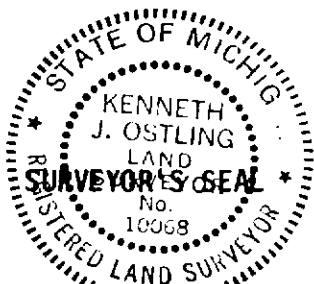

DISTRIBUTION:

SIGNED

Kenneth J. Ostling
REGISTERED LAND SURVEYOR

DATE

6-29-72

20068

Forestry Division, Lansing