

LAND CORNER RECORDATION CERTIFICATE
Filing Requirement of Act 74, Mich. P.A. 1970

For corners in

<u>Crawford</u> <small>(County)</small>	Located In:	Corner Code #
1. Public Land Survey	T <u>25N</u> R <u>3W</u>	<u>L-7</u>
	T <u>25N</u> R <u>3W</u>	<u>M-8</u>
	T _____ R _____	_____
	T _____ R _____	_____
2. Property Controlling in Section	S <u>24</u> T <u>25N</u> R <u>3W</u>	<u>5</u>
	S <u>24</u> T <u>25N</u> R <u>3W</u>	<u>7</u>
	S _____ T _____ R _____	_____
3. Miscellaneous Property in Sec.	S _____ T _____ R _____	_____

Register of Deeds Stamp & File Number

4. Lot No. _____, Recorded Plat _____
 5. Private Claims _____

	A	B	C	D	E	F	G	H	I	J	K	L	M
2	6	5	4	3	2	1							
3													
4	7	8	9	10	11	12							
5													
6	18	17	16	15	14	13							
7													
8	19	20	21	22	23	24							
9													
10	30	29	28	27	26	25							
11													
12	31	32	33	34	35	36							
13													

I, Carl R. Johnson, in a field survey on May 30, 19 89, do hereby certify that under requirements of P.A. 74, Michigan P.A. of 1970, the corner points mentioned in lines 1 and 2 above were in conformance with regulations and rules therefore as required in the current manual of survey instructions of the United States Department of the Interior, Bureau of Land Management or by a decree of a Court of Law and/or that the corner points mentioned in lines 3, 4 and 5 above were in conformance with the rules of the Michigan Board of Land Surveyors or by a Decree of a Court of Law; established, re-established, monumented, re-monumented, recovered, found as expressed below:

NOTE: Not more than 4 corners, all in the same town and range, may be recorded on this certificate.


A. Description of original monument and accessories and/or subsequent restoration:

- B. Description of corner evidence found and/or method applied in restoring or reestablishing corner:
- L-7 - Set midway and on line between section corners. No evidence of original or subsequent surveys.
- 5 - Set by standard survey procedure for subdivision of a section.
- 7 - Set midway and on line between $\frac{1}{4}$ corner and section corner.
- M-8 - Set midway and on line between section corners. No evidence of original or subsequent surveys.

C. Description of monument for corner and accessories established to perpetuate locating the position of the corner:

- | | | |
|---|---|--|
| <u>L-7 - N$\frac{1}{2}$ Corner</u> | <u>5 - N$\frac{1}{8}$, N-S $\frac{1}{4}$ Line</u> | <u>7 - N$\frac{1}{8}$, East Side Sec.24</u> |
| Set D.N.R. Monument | Set $\frac{5}{8}$ " bar w/cap | $\frac{5}{8}$ " bar w/cap |
| 6" J. Pine N 11°W 18.7' | 5" Cedar Post Due West 10' | 5" R. Oak N11°W 8.3' |
| 12" J. Pine N62°E 37.1' | 6" J. Pine N57°W 49.3' | 6" R. Oak N88°E 6.3' |
| 8" R. Oak S30°E 33.2' | 6" J. Pine N41°E 46.6' | 8" W. Oak S33°W 11.1' |
| 10" J. Pine S49°W 22.6' | 12" J. Pine S58°E 47.6' | |
| <u>M-8 - E$\frac{1}{2}$ Corner</u> | 8" J. Pine S31°W 51.9' | |
| Set D.N.R. Monument | | |
| 14" R. Oak N14°W 13.7' | | |
| 5" R. Oak N62°E 24.1' | | |
| 4" R. Oak S33°E 19.4' | | |

Signed by Carl R. Johnson
 Surveyor's Michigan License No. 30083

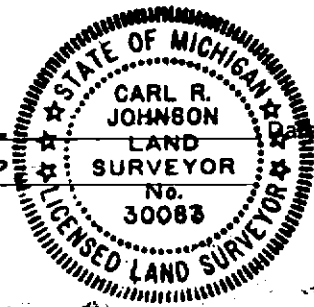

8/2/89

FORM APPROVED BY MICHIGAN STATE BOARD OF LAND SURVEYORS, JAN. 28, 1971
 REVISED MAY 14, 1975
 REVISED JAN., 1983