

LAND CORNER RECORDATION CERTIFICATE
Filing Requirement of Act 74, Mich. P.A. 1970

For corners in
CRANFORD

(County)	Located In:	Corner Code -#
1. Public Land Survey	T <u>25N</u> R <u>3W</u>	<u>E-8</u>
	T _____ R _____	_____
	T _____ R _____	_____
	T _____ R _____	_____
2. Property Controlling in Section	S _____ T _____ R _____	_____
	S _____ T _____ R _____	_____
3. Miscellaneous Property in Sec.	S _____ T _____ R _____	_____
	S _____ T _____ R _____	_____

Register of Deeds Stamp & File Number

4. Lot No. _____, Recorded Plat _____
 5. Private Claims _____

	A	B	C	D	E	F	G	H	I	J	K	L	M
2	6	5	4	3	2	1							
3													
4	7	8	9	10	11	12							
5													
6	18	17	16	15	14	13							
7													
8	19	20	21	22	23	24							
9													
10	30	29	28	27	26	25							
11													
12	31	32	33	34	35	36							
13													

I, C.F.ROSER, in a field survey on SEPT. 30, 19 90, do hereby certify that under requirements of P.A. 74, Michigan P.A. of 1970, the corner points mentioned in lines 1 and 2 above were in conformance with regulations and rules therefore as required in the current manual of survey instructions of the United States Department of the Interior, Bureau of Land Management or by a decree of a Court of Law and/or that the corner points mentioned in lines 3, 4 and 5 above were in conformance with the rules of the Michigan Board of Land Surveyors or by a Decree of a Court of Law; established, re-established, monumented, re-monumented, recovered, found as expressed below:

NOTE: Not more than 4 corners, all in the same town and range, may be recorded on this certificate.

A. Description of original monument and accessories and/or subsequent restoration:
 E-8

(NO EVIDENCE OF G.L.O. CORNER, B.T.'S, LINE TREES & TOPOGRAPHY AS CALLED OUT IN THE G.L.O. IN ITEM "B" BELOW.) LINE NOTES; UNLESS NOTED IN


NOTE: ABOVE LAND CORNER WAS RECOVERED AND FIELD CORNER RECORD COMPLETED, BY D.N.R. LAND SURVEYOR, CARL R. JOHNSON L.S.#30083 (NOW RETIRED). IT IS BEING RECORDED PER ACT 74, PA 1970, BY D.N.R. SURVEYOR, C.F.ROSER, P.S.#12028.

B. Description of corner evidence found and/or method applied in restoring or reestablishing corner:

E-8
 RE-WIT. ABOVE CORNER, FD 5/8" IRON ROD; FITS 2-1982 WIT'S. BY PS, N.PARKER. REF: E-8, E1/4 SEC. 20, LIBER 2, PG.249.

C. Description of monument for corner and accessories established to perpetuate locating the position of the corner:

E-8
 FOUND 5/8" IRON ROD, CTR. N & S ROAD, 6" BELOW GRADE.
 12" JACK PINE N46°W 52.0'
 12" DBL.OAK S81°W 34.55'
 14" OAK S53°W 41.72'
 120" OAK STP. N85°E 38.8'
 POWER POLE S86°E 34.9'

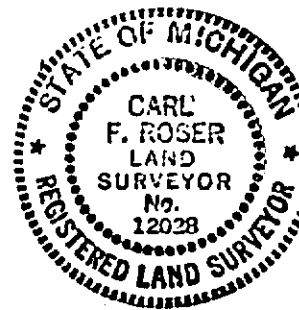

1- 1982 WIT'S. BY N.PARKER.

Signed by Carl F. Roser 5-04-94 Date _____
 _____ 12028

Surveyor's Michigan License No. _____