LAND CORNER RECORDATION CERTIFICATE

Filing Requirement of Act 74, Mich. P.A. 1970

For corners in CRAWFORD (County)

	Located In:	Corner Code #1
1. Public Land Survey	T 25N R 3W	C-11
	T ___ R ___	
	T ___ R ___	
	T ___ R ___	
2. Property Controlling in Section	S 30 T ___ R ___	12, 13, 14
	S ___ T ___ R ___	
3. Miscellaneous Property in Sec.	S ___ T ___ R ___	
	S ___ T ___ R ___	

Register of Deeds Stamp & File Number

4. Lot No. _____ , Recorded Plat _____
5. Private Claims _____

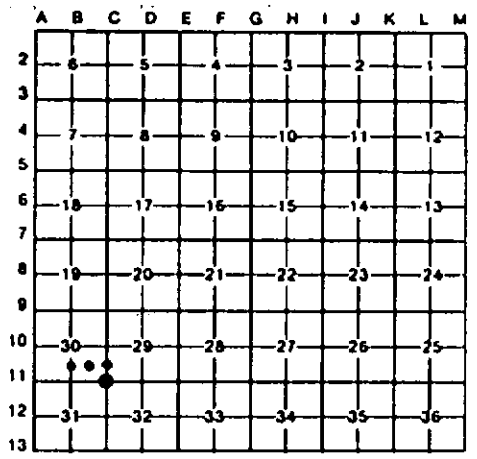

I, CARL F. ROSER, in a field survey on NOVEMBER 9, 19 94, do hereby certify that under requirements of P.A. 74, Michigan P.A. of 1970, the corner points mentioned in lines 1 and 2 above were in conformance with regulations and rules therefore as required in the current manual of survey instructions of the United States Department of the Interior, Bureau of Land Management or by a decree of a Court of Law and/or that the corner points mentioned in lines 3, 4 and 5 above were in conformance with the rules of the Michigan Board of Land Surveyors or by a Decree of a Court of Law; established, re-established, monumented, re-monumented, recovered, found as expressed below:

NOTE: Not more than 4 corners, all in the same town and range, may be recorded on this certificate.

A. Description of original monument and accessories and/or subsequent restoration:

C-11 12 13 14

(NO EVIDENCE OF G.L.O. CORNER, B.T'S, LINE TREES & TOPOGRAPHY, AS CALLED OUT IN THE G.L.O. LINE NOTES; UNLESS NOTED IN ITEM "B" BELOW.)

STATE OF MICHIGAN
CARL F. ROSER
LAND SURVEYOR
No. 12028
REGISTERED LAND SURVEYOR

B. Description of corner evidence found and/or method applied in restoring or reestablishing corner:

C-11	12	13	14
FD IRON ROD FOR SE COR SEC 30.	ESTABLISHED SW COR OF NW 1/4 OF SE 1/4 OF S-30 PER STANDARD BLM INSTRUCTIONS. CLEAR CUT AREA TO NE.	ESTABLISHED CTR OF SE 1/4 OF SEC 30 PER STANDARD BLM INSTRUCTIONS. CEDAR POST WAS SET 0.8' NORTH OF REROD.	FD ANGLE IRON AT FENCE CORNER FOR NE COR OF SE 1/4 OF SE 1/4 SEC 30. CORNER FITS MIDWAY & ON LINE BETWEEN FD 1/4 COR (1/2 MILE NORTH) & SEC COR (1/2 MILE SOUTH) ± 0.6'.

C. Description of monument for corner and accessories established to perpetuate locating the position of the corner:

C-11	12	13	14
FOUND 1/2" IRON ROD W/CAP B.JONES #23514.	SET 5/8" X 32" REROD W/CAP & CED POST.	DROVE 5/8" X 32" CAPPED REROD & CED POST.	FD 1 1/4" X 1 1/4" ANGLE IRON AT FENCE COR. SET CED POST. (UPPER BLAZES & SIDE NAILS)
4" SPRUCE N20°W 3.95'	#8" JACK PINE S35°E 4.85'	#8" J PINE S73°E 10.20'	#12" JACK PINE S43°E 4.60'
#4" SPRUCE N56°E 18.21'	8" R PINE S28°W 24.58'	#8" J PINE S22°W 21.29'	#10" JACK PINE S03°W 18.97'
4" SPRUCE S39°E 13.57'	6" OAK N37°W 16.37'	7" J PINE S75°W 30.93'	3" OAK S86°W 51.71'
4" SPRUCE S05°W 18.99'	10" JACK PINE N08°E 23.88'	CLEARCUT NE, NW & SE.	4" JACK PINE N45°E 28.92'
(UPPER BLAZES & SIDE NAILS)	(UPPER BLAZES & SIDE NAILS)		FENCE N & E. CLEARCUT NW, SW & SE.
#L.CAVANAUGH 1985 WIT.	#OLD WIT BY OTHERS.	#OLD WITS BUT NO CORNERS	#OLD WITNESS BY OTHERS

Signed by Carl F. Roser Date 6-29-95

Surveyor's Michigan License No. 12028

FORM APPROVED BY MICHIGAN STATE BOARD OF LAND SURVEYORS, JAN. 28, 1971
REVISED MAY 14, 1975
REVISED JAN. 1983