

**LAND CORNER RECORDATION CERTIFICATE**  
**Filing Requirement of Act 74, Mich. P.A. 1970**

For corners in  
**CRANFORD**

(County)

Located In:

Corner Code  $\neq$

1. Public Land Survey	T	25N	R	3W	A-7, A-8,
	T		R		A-9, B-9
	T		R		
	T		R		
2. Property Controlling in Section	S		T	R	
	S		T	R	
3. Miscellaneous Property in Sec.	S		T	R	
	S		T	R	

Register of Deeds Stamp & File Number

4. Lot No. \_\_\_\_\_, Recorded Plat \_\_\_\_\_  
 5. Private Claims \_\_\_\_\_


I, CARL F. ROSER, in a field survey on JULY 13, 19 94, do hereby certify that under requirements of P.A. 74, Michigan P.A. of 1970, the corner points mentioned in lines 1 and 2 above were in conformance with regulations and rules therefor as required in the current manual of survey instructions of the United States Department of the Interior, Bureau of Land Management or by a decree of a Court of Law and/or that the corner points mentioned in lines 3, 4 and 5 above were in conformance with the rules of the Michigan Board of Land Surveyors or by a Decree of a Court of Law; established, re-established, monumented, re-monumented, recovered, found as expressed below:

**NOTE: Not more than 4 corners, all in the same town and range, may be recorded on this certificate.**

A. Description of original monument and accessories and/or subsequent restoration:

(NO EVIDENCE OF G.L.O. CORNER, B.T.'S, LINE TREES & TOPOGRAPHY, AS CALLED OUT IN THE G.L.O. LINE NOTES; UNLESS NOTED IN ITEM "B" BELOW.)

A	B	C	D	E	F	G	H	I	J	K	L	M
2	6	5	4	3	2	1						
3												
4	7	8	9	10	11	12						
5												
6	16	17	16	15	14	13						
7												
8	19	20	21	22	23	24						
9												
10	30	29	28	27	26	25						
11												
12	31	32	33	34	35	36						
13												

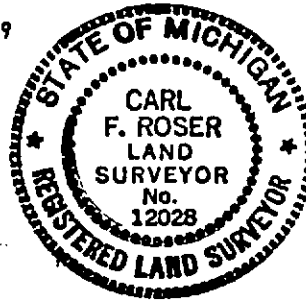

B. Description of corner evidence found and/or method applied in restoring or reestablishing corner:

<b>A-7</b> FD IRON W/B. JONES RLS CAP FOR NW COR SECTION 19. COR ALSO FITS 1974 SURVEY BY G. HENNING (RECORDED IN BOOK 137, PG 233). IN NE 1/4 OF S-24, T25N-R4W. FD BOAT SPIKE, 18" DEEP, N78° 37'W, 11.50'; BOLT NOT ACCEPTED. COR IS IN INTERSEC OF OAK ROAD (N-S GRAVEL) & SEVEN MILE ROAD (E-W GRAVEL).	<b>A-8</b> FD B. JONES IRON FOR N 1/4 COR S-19. COR ALSO FITS SURVEY BY G. HENNING (BOOK 145, PG 505) IN SW 1/4 S-19. CTR OF N-S GRAVEL RD IS 6' WEST.	<b>A-9</b> FD 1 1/2" IRON BAR FOR NW COR SEC 30. CORNER FITS SURVEYS IN SEC 19 & 30 BY F. J. ARLETH & G. HENNING. FD 2" PIPE; 18" DEEP, N88°52'E, 10.08'. THIS IS PROBABLY M. SCHAAF (CONS DEPT FORESTER/SURVEYOR 1920'S-40'S) CORNER BUT IT HAS NOT BEEN ACCEPTED IN ANY OTHER SURVEYS IN THE AREA.	<b>B-9</b> FD R.R. SPIKE FOR N 1/4 COR SEC 30. COR FD & USED BY L. CAVANAGH IN 1973 SURVEY (BOX 130, PG 561) & BY F. J. ARLETH IN 1989 SURVEY IN NW 1/4 S-30.
---	---	---	--

C. Description of monument for corner and accessories established to perpetuate locating the position of the corner:

<b>A-7</b> FD. CAPPED IRON - B. JONES #POWER POLE N42°W 49.98' #J PINE N60°E 55.61' #POWER POLE S41°W 84.56' #J PINE S48°E 90.85'  #OLD WITNESSES	<b>A-8</b> FD. CAPPED IRON - B. JONES #23514 FD REROD S89°05'W 32.96' #POWER POLE S88°E 27.36' # 6" J PINE S54°W 42.07' #18" J PINE N40°E 61.34' # 4" J PINE N42°W 72.88'  #OLD WITNESSES	<b>A-9</b> FD. 1 1/2" IRON BAR IN RD INTERSEC. FD. 2" PIPE (18" DEEP) EAST 10.34' #POWER POLE N60°E 49.71' #GUY POLE S48°E 48.80' # 16" R PINE S44°W 39.31' STOP SIGN POST N04°W 51.47'  #F. J. ARLETH WIT.	<b>B-9</b> FD. R.R. SPIKE IN FLETCHER RD. C/L FLETCHER RD SOUTH 2' #POWER POLE S01°W 35.41' EAST GATE POST S33°E 43.38' # 8" TWIN OAK N18°E 33.55' # 14" J PINE N54°W 61.85' FD CAPPED IRON #21266 S06°W 33.00'
--	---	---	--

Signed by Carl F. Roser Date 6-29-95  
 Surveyor's Michigan License No. 12028