

# LAND CORNER RECORDATION CERTIFICATE


Filing Requirement of Act 74, Mich. PA 1970

For Corners In: <u>Crawford</u> (County)	Located In	Corner Code #	
1. Public Land Survey	T _____ R _____		
	T _____ R _____		
2. Property Controlling in Section	S <u>18</u> T <u>25N</u> R <u>3W</u>		<u>14</u>
	S <u>18</u> T <u>25N</u> R <u>3W</u>		<u>16</u>
3. Miscellaneous Property in Section	S _____ T _____ R _____		
	S _____ T _____ R _____		
4. Lot No: _____	Recorded Plat: _____		
5. Private Claims: _____			

Register of Deeds Stamp & File Number

I, Carl T. Kiiskila, in a field survey on May 28, 2003 do hereby state that under requirements of PA 74, Michigan PA of 1970, the corner points mentioned in lines 1 and 2 above were in conformance with regulations and rules therefore as required in the current manual of survey instructions of the United States Department of the Interior, Bureau of Land Management or by a decree of a Court of Law and/or that the corner points mentioned in lines 3, 4 and 5 above were in conformance with the rules of the Michigan Board of Land Surveyors or by a Decree of a Court of Law; established, re-established, monumented, recovered, found as expressed below:

**NOTE: Not more than 2 corners, all in the same town and range, may be recorded on this certificate.**

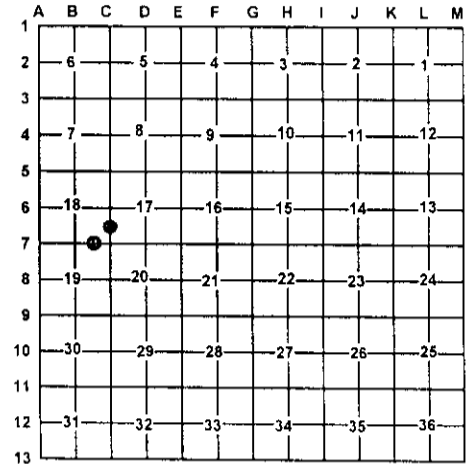

A. Description of original monument and accessories and/or subsequent restoration:

14- Marvin E. Myers P.S. # 31600 set a P.K. nail for the Northeast corner of the Southeast quarter of the Southeast quarter of section 18, in February of 1991.

16- Marvin E. Myers P.S. #31600 set a 1/2" X 18" steel bar for the Southwest corner of the Southeast quarter of the Southeast quarter of section 18, in February of 1991.

B. Description of corner evidence found and/or method applies in restoring or re-establishing corner:

14- Found P. K. nail in centerline of Grayling Road, replaced with 5/8" X 16" rerod with P.S. cap #33981

16- Found 1/2" rod and added P.S. cap #33981

C. Description of monument for corner and accessories established to perpetuate locating the position of the corner:

14- 5/8" X 16" rerod with P.S. Cap #33981  
 Wit: 4" J. Pine N72°W 37.66'  
 14" Oak N49°E 66.10'  
 12" Oak S28°W 99.40'  
 4" Aspen S38°E 41.88'

16- Found 1/2" rod added P.S. cap #33981  
 Wit: 6" J. Pine N48°E 52.48'  
 12" J. Pine N54°W 83.22'  
 P. Pole S37°E 34.75'  
 6" J. Pine S38°W 60.58'  
 4" X 4" post N07°E 32.5'±  
 Centerline East/ West road North 3'±

Signed by:

Carl T. Kiiskila

Date:

7-1-03

Surveyor's Michigan License No.:

33981

