

# LAND CORNER RECORDATION CERTIFICATE

Filing Requirement of Act 74, Mich. PA 1970

For Corners In: Crawford (County)	Located In	Corner Code #
1. Public Land Survey	T <u>25N</u> R <u>3W</u>	<u>E-4</u>
	T _____ R _____	_____
2. Property Controlling in Section	S _____ T _____ R _____	_____
	S _____ T _____ R _____	_____
3. Miscellaneous Property in Section	S _____ T _____ R _____	_____
	S _____ T _____ R _____	_____


4. Lot No: \_\_\_\_\_ Recorded Plat: \_\_\_\_\_

5. Private Claims: \_\_\_\_\_

I, Carl T. Kiiskila, in a field survey on January 19, 2001 do hereby state that under requirements of PA 74, Michigan PA of 1970, the corner points mentioned in lines 1 and 2 above were in conformance with regulations and rules therefore as required in the current manual of survey instructions of the United States Department of the Interior, Bureau of Land Management or by a decree of a Court of Law and/or that the corner points mentioned in lines 3, 4 and 5 above were in conformance with the rules of the Michigan Board of Land Surveyors or by a Decree of a Court of Law; established, re-established, monumented, recovered, found as expressed below:

**NOTE: Not more than 2 corners, all in the same town and range, may be recorded on this certificate.**

Register of Deeds Stamp & File Number

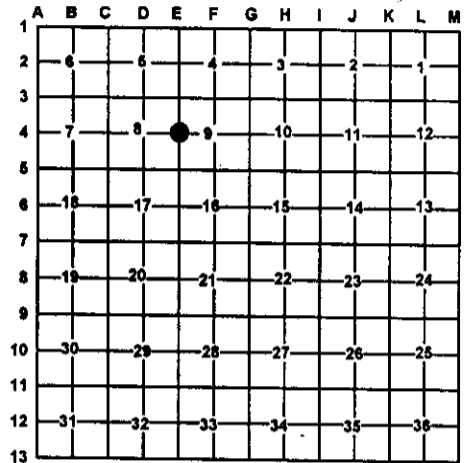

**A. Description of original monument and accessories and/or subsequent restoration:**

E-4 G.L.O. Addison P. Brewer D.S. August 1852  
Set quarter section post  
Wit: Yellow Pine 14 N32°E 10 links  
Yellow Pine 13 S48°W 37links

George D. Henning RLS #2240 Sept. 1980 subdivision plat  
"Skyline Forest Estates" L.253 P.20 Found 2 1/2" pipe no  
witnesses on plat.

Matt Koivisto R.L.S. #16047 Sept. 1969 M.D.S.H. Witnessed  
record "Found steel fence post with square wood stake  
beside it" Wit: 7" Oak S45°E 10.02', 7" Oak S70°W 9.61', 16"  
Oak N50°E 39.76'

Consumers Power survey by H.A. Rhines June 1992 found  
1 3/4" pipe  
Wit: 20" Oak N54°E 40.21', 12" Oak N25°E 46.81' 6" Oak  
S72°W 9.32', 6" Oak S38°E 10.26'

**B. Description of corner evidence found and/or method applies in restoring or re-establishing corner:**

E-4 Found 2" pipe fitting G.D.Henning's distance West

**C. Description of monument for corner and accessories established to perpetuate locating the position of the corner:**

E-4 Found 2" pipe  
Wit: 10" Oak N47°W 66.37'  
6" Twin Oak S34°W 36.45'  
5" Oak S60°E 32.88'  
5" Oak N20°E 18.64'



Signed by: Carl T. Kiiskila  
Surveyor's Michigan License No.: 33981

Date: 11-27-01