

**SURVEY &  
REMONUMENTATION**

SEP 20 1999

**LAND CORNER RECORDATION CERTIFICATE  
Filing Requirement of Act 74, Mich. P.A. 1970**

**SECTION**

For corners in

<u>Crawford</u> (County)	Located In:	Corner Code #
1. Public Land Survey	Sec. <u>T 26NR 4W</u>	<u>C-13</u>
	Sec. <u>T 25N R 4W</u>	<u>C-1</u>
	T _____ R _____	_____
	T _____ R _____	_____
2. Property Controlling in Section	S _____ T _____ R _____	_____
	S _____ T _____ R _____	_____
3. Miscellaneous Property in Sec.	S _____ T _____ R _____	_____
	S _____ T _____ R _____	_____

STATE OF MICHIGAN  
CRAWFORD COUNTY  
RECORDED

19 DEC 97 2:38 P.M.

SANDRA MOORE  
REGISTER OF DEEDS

Register of Deeds Stamp & File  
Number

4. Lot No. \_\_\_\_\_, Recorded Plat **LIBER 3**

5. Private Claims \_\_\_\_\_

**PAGE 292**

	A	B	C	D	E	F	G	H	I	J	K	L	M
1													
2	6	5	4	3	2	1							
3													
4	7	8	9	10	11	12							
5													
6	18	17	16	15	14	13							
7													
8	19	20	21	22	23	24							
9													
10	30	29	28	27	26	25							
11													
12	31	32	33	34	35	36							
13													

I, Marvin E. Myers, in a field survey on September, 1997 do hereby state that under requirements of P.A. 74, Michigan P.A. of 1970, the corner points mentioned in lines 1 and 2 above were in conformance with regulations and rules therefore as required in the current manual of survey instructions of the United States Department of the Interior, Bureau of Land Management or by a decree of a Court of Law and/or that the corner points mentioned in lines 3, 4 and 5 above were in conformance with the rules of the Michigan Board of Land Surveyors or by a Decree of a Court of Law; established, re-established, monumented, recovered, found as expressed below:

**NOTE: Not more than 2 corners, all in the same town and range, may be recorded on this certificate.**

A. Description of original monument and accessories and/or subsequent restoration:

G.L.O. April 16, 1839 H. Brevoort D.S. & James H. Mullet D.S. Mon: Post Wit: 10" Pine N39°E 17 links 16" Pine N44°E 50 links	Michigan Department of Conservation Billy D. Buckler R.L.S. July 31, 1957 Corner established by single proportionate measurement between probable original corner 1 mile east, and Houghton Town corner 1 mile west. Mon: 1" pipe with 4" brass cap Wit: 10" Jack Pine N18°W 23 ½ links 8" Jack Pine S71°W 47 ½ links 7" Jack Pine S60°W 45 links
--	---

**CRAWFORD COUNTY  
PEER GROUP APPROVAL  
DATE OCT 16, 1997**


*Marvin E. Myers*  
**Marvin E. Myers, P.S.  
County Surveyor**

B. Description of corner evidence found and/or method applied in restoring or reestablishing corner:

Found 1" pipe with remnants of Conservation Department Cap. Replace in exact location with Standard Crawford County Monument. This position was accepted as a reestablishment of the position of the Original Government Corner.

C. Description of monument for corner and accessories established to perpetuate locating the position of the corner:

Mon - Standard Crawford County Monument  
Set nail & tag in S.E side 16" Black Oak N71°E 29.95'  
Set nail & tag in E. side 14" Maple S14°W 59.15'  
Set nail & tag in NW side 8" Black Oak S49°W 37.56'  
Set nail & tag in N. Side 6" Jack Pine N70°W 56.04'  
Set Carsonite Post North 1'

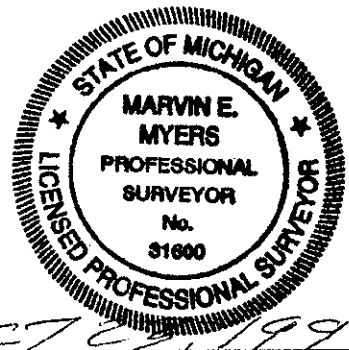

Signed by *Marvin E. Myers* Date OCT 27, 1997  
Surveyor's Michigan License No. 31600