

MAR 29 2000

SECTION

LAND CORNER RECORDATION CERTIFICATE
Filing Requirement of Act 74, Mich. P.A. 1970

For corners in

<u>Crawford</u> (County)	Located In:	Corner Code #
1. Public Land Survey	T <u>25N</u> R <u>4W</u>	<u>C-11</u>
	T _____ R _____	_____
	T _____ R _____	_____
	T _____ R _____	_____
2. Property Controlling in Section	S _____ T _____ R _____	_____
	S _____ T _____ R _____	_____
3. Miscellaneous Property in Sec.	S _____ T _____ R _____	_____
	S _____ T _____ R _____	_____

STATE OF MICHIGAN
CRAWFORD COUNTY
RECORDED

17 AUG 99 12:33 P.M.

SANDRA NOBRE
REGISTER OF DEEDS

Register of Deeds Stamp & File Number

4. Lot No. _____, Recorded Plat _____
5. Private Claims _____

LIBER 4 PAGE 27

I, Marvin E. Myers, in a field survey on August 26, 1997 do hereby state that under requirements of P.A. 74, Michigan P.A. of 1970, the corner points mentioned in lines 1 and 2 above were in conformance with regulations and rules therefore as required in the current manual of survey instructions of the United States Department of the Interior, Bureau of Land Management or by a decree of a Court of Law and for that the corner points mentioned in lines 3, 4 and 5 above were in conformance with the rules of the Michigan Board of Land Surveyors or by a Decree of a Court of Law; established, re-established, monumented, recovered, found as expressed below:

A	B	C	D	E	F	G	H	I	J	K	L	M
1												
2	6	5	4	3	2	1						
3												
4	7	8	9	10	11	12						
5												
6	18	17	16	15	14	13						
7												
8	19	20	21	22	23	24						
9												
10	30	29	28	27	26	25						
11												
12	31	32	33	34	35	36						
13												

NOTE: Not more than 2 corners, all in the same town and range, may be recorded on this certificate.

A. Description of original monument and accessories and/or subsequent restoration:

G.L.O - 1852, Addison Brewer, D.S. Mon. - Post 8" S. Pine N34°30'W 197 lks. 14" W. Pine S14°E 272 lks.	Norman F. Parker, R.L.S.#16939 Survey L.192, P.489 dated 1980 Mon: DNR pipe Wit: none provided	Norman F. Parker, R.L.S.#16939 Survey L.192, P.500 dated 1980 Mon: DNR pipe (1 1/4" pipe) Wit: none provided
---	---	---

Note: There is a line through the distance, indicated by a "?", in the original GLO notes.

1930's M. Schaaf
Mon - Iron

B. Description of corner evidence found and/or method applied in restoring or reestablishing corner:

Found 1 1/4"x18" pipe with concrete base (typical Schaaf) of record in intersection of trail roads North, South, and West. Accepted pipe as the best available evidence of the position of the Original Corner. Replaced Pipe with Standard Crawford County Monument.

C. Description of monument for corner and accessories established to perpetuate locating the position of the corner:


Mon - Standard County Corner.
Wit: Spike in 8" Red Oak N09°W 16.6'
Spike in 22" White Oak N59°E 27.78'
Spike in 6" Red Oak S10°E 47.02'
Spike in 24" White Oak S64°W 28.82'
Carsonite Post S30°W 19.0

CRAWFORD COUNTY
PEER GROUP APPROVAL

DATE June 7, 1999

Marvin E. Myers
Marvin E. Myers, P.S.
County Surveyor

Signed by *Marvin E. Myers*
Surveyor's Michigan License No. 31600

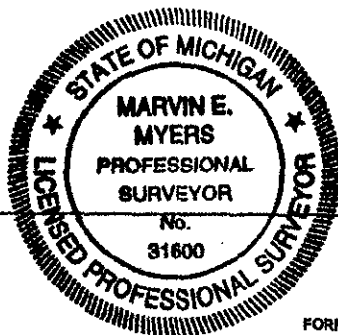

Date June 9, 1999