

MAR 29 2000

LAND CORNER RECORDATION CERTIFICATE
 Filing Requirement of Act 74, Mich. P.A. 1970

STATE OF MICHIGAN
 CRAWFORD COUNTY
 RECORDED

17 AUG 99 12:32 P.M.

SANDRA MOORE
 REGISTER OF DEEDS

Register of Deeds Stamp & File Number

SECTION

For corners in

Crawford

(County)

Located In:

Corner Code #

1. Public Land Survey	T <u>25N</u> R <u>4W</u>	<u>E-7</u>
	T _____ R _____	_____
	T _____ R _____	_____
	T _____ R _____	_____
2. Property Controlling in Section	S _____ T _____ R _____	_____
	S _____ T _____ R _____	_____
3. Miscellaneous Property In Sec.	S _____ T _____ R _____	_____
	S _____ T _____ R _____	_____

4. Lot No. _____, Recorded Plat _____
 5. Private Claims _____

LIBER 4 PAGE 21

I, Marvin E. Myers, in a field survey on Dec 29, 1998, do hereby state that under requirements of P.A. 74, Michigan P.A. of 1970, the corner points mentioned in lines 1 and 2 above were in conformance with regulations and rules therefore as required in the current manual of survey instructions of the United States Department of the Interior, Bureau of Land Management or by a decree of a Court of Law and /or that the corner points mentioned in lines 3, 4 and 5 above were in conformance with the rules of the Michigan Board of Land Surveyors or by a Decree of a Court of Law; established, re-established, monumented, recovered, found as expressed below:

1	A	B	C	D	E	F	G	H	I	J	K	L	M
2	6	5	4	3	2	1							
3													
4	7	8	9	10	11	12							
5													
6	18	17	16	15	14	13							
7													
8	19	20	21	22	23	24							
9													
10	30	29	28	27	26	25							
11													
12	31	32	33	34	35	36							
13													

NOTE: Not more than 2 corners, all in the same town and range, may be recorded on this certificate.

A. Description of original monument and accessories and/or subsequent restoration:

G.L.O - 1852 Addison P. Brewer, DS	May 1879 Co. Surveyor's Book	June 27, 1923 E. Houghton #1122
Mon. - Set Y. Pine Post	Mon - not given	Mon - Set Clay Tile Monument
Wit: 12" S. Pine N64°E 18 lks.	Wit: 24" Y. Pine S62 ½°W 130 ½ lks.	
9" S. Pine S55°W 26 lks.	10" Y. Pine S58 ½°E 90 ½ lks	

1930's M. Schaaf	L. 2, P. 195 LCRC Oct 1978 K. Osting #10068
Mon- Iron (sunk)	Mon - Fd. ½" bar in concrete tile and 2" Pipe In Centerline
	E-W road replaced with DNR Monument
	Wit: 16" Oak N06°E 71.0
	8" R. Pine S62°E 99.95
	Cedar Post North 40.00

B. Description of corner evidence found and/or method applied in restoring or reestablishing corner:

Found DNR monument in centerline of 7 mile road; found cedar post North 40.00; found 8" (now 18") R. Pine S62°E 99.8 to face; found (now 25" W. Oak N06°E 71.8 to face. Accepted DNR monument as the best available evidence of the position of the Original Governme corner. Left DNR monument in place.


C. Description of monument for corner and accessories established to perpetuate locating the position of the corner:

Mon - Left DNR monument in place.
 Wit: Carsonite Post N24°E 30.6
 Cedar post North 40.00
 Nail in SW side 18" Norway S26°E 100.39
 Nail in W. side 5" J. Pine S36°W 50.80

CRAWFORD COUNTY
 PEER GROUP APPROVAL
 DATE June 7, 1999

Marvin E. Myers
 Marvin E. Myers, P.S.
 County Surveyor

Signed by *Marvin E. Myers*
 Surveyor's Michigan License No. 31600

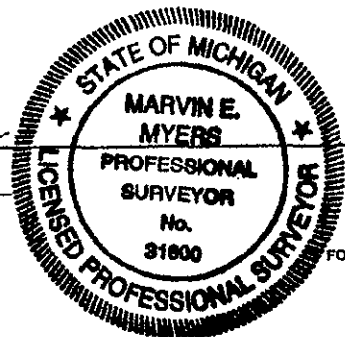

Date June 9, 1999