

MAR 29 2000

LAND CORNER RECORDATION CERTIFICATE
Filing Requirement of Act 74, Mich. P.A. 1970

SECTION

For corners in

Crawford
(County)

Located In:

Corner Code #

- 1. Public Land Survey T 25N R 4W E-9
- T _____ R _____
- T _____ R _____
- T _____ R _____
- 2. Property Controlling S _____ T _____ R _____
- in Section S _____ T _____ R _____
- 3. Miscellaneous S _____ T _____ R _____
- Property in Sec. S _____ T _____ R _____

STATE OF MICHIGAN
CRAWFORD COUNTY
RECORDED

17 AUG 99 12:34 P.M.

SANDRA MOORE
REGISTER OF DEEDS

Register of Deeds Stamp & File Number

4. Lot No. _____, Recorded Plat _____

5. Private Claims **LIBER 4 PAGE 31**

I, Marvin E. Myers, in a field survey on Dec 29, 1998 do hereby state that under requirements of P.A. 74, Michigan P.A. of 1970, the corner points mentioned in lines 1 and 2 above were in conformance with regulations and rules therefore as required in the current manual of survey instructions of the United States Department of the Interior, Bureau of Land Management or by a decree of a Court of Law and /or that the corner points mentioned in lines 3, 4 and 5 above were in conformance with the rules of the Michigan Board of Land Surveyors or by a Decree of a Court of Law; established, re-established, monumented, recovered, found as expressed below.

NOTE: Not more than 2 corners, all in the same town and range, may be recorded on this certificate.

1	A	B	C	D	E	F	G	H	I	J	K	L	M
2	6		5		4		3		2		1		
3													
4	7		8		9		10		11		12		
5													
6	18		17		16		15		14		13		
7													
8	19		20		21		22		23		24		
9													
10	30		29		28		27		26		25		
11													
12	31		32		33		34		35		36		
13													

A. Description of original monument and accessories and/or subsequent restoration:

G.L.O - 1852 Addison P. Brewer, DS
Mon. - Set Post
8" S. Pine N88°E 492 lks.
8" S. Pine S10°W 583 lks.

B. Description of corner evidence found and/or method applied in restoring or reestablishing corner:

Found 1/2" bar in centerline of Fletcher Road E-W. Distance East to F-9 2630.84; distance East to G-9 5262.84; distance South to E-10 2644.44; distance South to E-11 5288.97; distance West to D-9 2632.09; distance North to E-8 2646.32
Accepted 1/2" bar as the best available evidence of the position of the Original Corner. Replaced 1/2" bar with Standard Crawford County Monument in pavement monument box.


C. Description of monument for corner and accessories established to perpetuate locating the position of the corner:

Mon - Standard Crawford County Monument in Pavement Monument box.
Wit: Carsonite Post N25°E 30.85
Spike in 4" W. Pine S59°W 93.09
Spike in 6" J. Pine S23°W 61.21
#28 pipeline marker post S40°E 53.47
Spike NE side 12" W. Pine N63°E 67.40
Spike SW side 12" W. Pine N39°W 74.71
Centerline of trail road S. is East 62'±
Centerline of trail road N. is West 41'±

CRAWFORD COUNTY
PEER GROUP APPROVAL
DATE June 7, 1999

Marvin E. Myers
Marvin E. Myers, P.S.
County Surveyor

Signed by *Marvin E. Myers*
Surveyor's Michigan License No. 31600

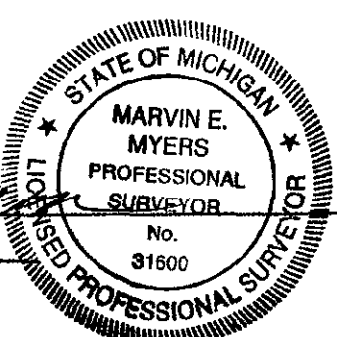

Date June 9, 1999