SURVEY & REMONUMENTATION

MAR 29 2000

SECTION

LAND CORNER RECORDATION CERTIFICATE
Filing Requirement of Act 74, Mich. P.A. 1970

STATE OF MICHIGAN
CRAWFORD COUNTY
RECORDED

17 AUG 99 12:32 P.M.

SANDRA MOORE
REGISTER OF DEEDS

Register of Deeds Stamp & File Number

For corners in

CRAWFORD
(County)

		Located In:	Corner Code #
1. Public Land Survey		T 25N R 4W	F-11
		T ___ R ___	
		T ___ R ___	
		T ___ R ___	
2. Property Controlling	S ___	T ___ R ___	
in Section	S ___	T ___ R ___	
3. Miscellaneous	S ___	T ___ R ___	
Property in Sec.	S ___	T ___ R ___	

4. Lot No. _____, Recorded Plat _____
5. Private Claims_____

LIBER 4 PAGE 19

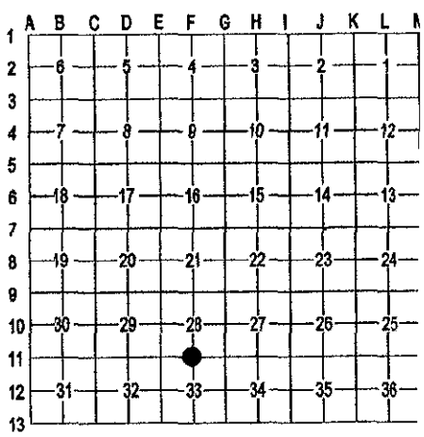

I, Marvin E. Myers, in a field survey on 10-16, 1998 do hereby state that under requirements of P.A. 74, Michigan P.A. of 1970, the corner points mentioned in lines 1 and 2 above were in conformance with regulations and rules therefore as required in the current manual of survey instructions of the United States Department of the Interior, Bureau of Land Management or by a decree of a Court of Law and /or that the corner points mentioned in lines 3, 4 and 5 above were in conformance with the rules of the Michigan Board of Land Surveyors or by a Decree of a Court of Law; established, re-established, monumented, recovered, found as expressed below:

NOTE: Not more than 2 corners, all in the same town and range, may be recorded on this certificate.

A. Description of original monument and accessories and/or subsequent restoration:

GLO – 1852 A.P. Brewer, DS — 1930's M. Schaaf
MON – POST — Mon - Iron
Wit: 10" W. PINE N85°W 24 LKS.
10" S. PINE S84°E 17 LKS.

B. Description of corner evidence found and/or method applied in restoring or reestablishing corner:

The Schaaf monument at this location has been obliterated by road construction a midway and online position was computed to narrow the seach area. M. Schaaf notes indicate that he established irons at 1/8 corners the East 1/8 corner was found and a position for the South ¼ was computed by extend and doubling over the 1/8 line distance the two positions fall within the intersection of trail roads where deep cuts were made and are within 6 feet of each other. The 1/8 corner was used as collateral evidence to reestablish the position of the ¼ corner. This positon is near the intersection of the N-S & E-W trails. Accepted position as a careful and faithful establishment of the position of the corner. Set Standard Crawford County Monument *0.5 below surface.*

C. Description of monument for corner and accessories established to perpetuate locating the position of the corner:

Mon - Standard Crawford County Monument.
Wit: SPIKE. 6" W. PINE N57°W 28.91'
SPIKE. 6" W. PINE S16°W 38.06'
SPIKE. 10" OAK S51°E 40.29'
SPIKE. 10" OAK N40°E 21.79'

CRAWFORD COUNTY
PEER GROUP APPROVAL
DATE June 7, 1999
Marvin E. Myers MEM
Marvin E. Myers, P.S.
County Surveyor

STATE OF MICHIGAN
MARVIN E. MYERS
PROFESSIONAL SURVEYOR
No. 31600
LICENSED PROFESSIONAL SURVEYOR

Signed by Marvin E. Myers
Surveyor's Michigan License No. 31600

Date June 9, 1999

FORM APPROVED BY MICHIGAN STATE BOARD OF PROFESSIONAL SURVEYORS, JAN. 26
REVISED MAY 14
REVISED JAN.
REVISED OCT.