

SURVEY & REMONUMENTATION

MAY 05 1997



LAND CORNER RECORDATION CERTIFICATE
Filing Requirement of Act 74, Mich. P.A. 1970

For corners in COMMISSION
Crawford
(County)

Located In:

Corner Code #

- 1. Public Land Survey T 25N R 3W
 T 25N R 4W
 T _____ R _____
 T _____ R _____
- 2. Property Controlling S _____ T _____ R _____
 in Section S _____ T _____ R _____
- 3. Miscellaneous S _____ T _____ R _____
 Property In Section S _____ T _____ R _____

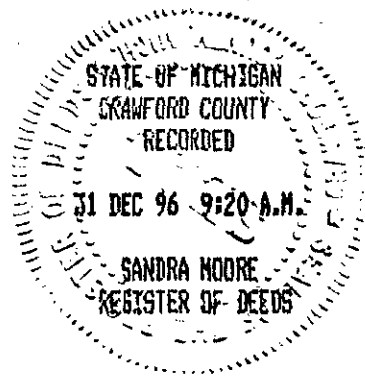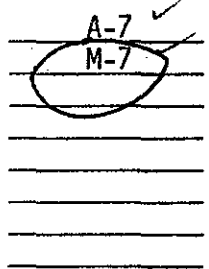

Register of Deeds Stamp & File Number

- 4. Lot No. _____, Recorded Plat _____
- 5. Private Claims _____

LIBER 3 PAGE 240

I, Larry L. Cavanagh, in a field survey on November, 19 96, do hereby certify that under requirements of P.A. 74, Michigan P.A. of 1970, the corner points mentioned in lines 1 and 2 above were in conformance with regulations and rules therefore as required in the current manual of survey instructions of the United States Department of the Interior, Bureau of Land Management or by a decree of a Court of Law and/or that the corner points mentioned in lines 3, 4 and 5 above were in conformance with the rules of the Michigan Board of Professional Surveyors or by a Decree of a Court of Law; established, re-established, monumented, re-monumented, recovered, found as expressed below:

A	B	C	D	E	F	G	H	I	J	K	L	M
2	6	5	4	3	2	1						
3												
4	7	6	5	4	3	2	1					
5												
6	16	17	18	15	14	13						
7												
8	19	20	21	22	23	24						
9												
10	30	29	28	27	26	25						
11												
12	31	32	33	34	35	36						
13												

NOTE: Not more than 4 corners, all in the same town and range, may be recorded on this certificate.

A. Description of original monument and accessories and/or subsequent restoration:

POST SET BY ADDISON P. BREWER 1852
WIT: Y. PINE 12" N83° 92 LINKS
Y. PINE 10" S5°W 76 LINKS

GEORGE D. HENNING 1954
3" PIPE IN ROAD
WIT: 16" NORWAY N44 1/2°E 83.7'
S.E. COR FD. N47°W 95.2'
8" J. PINE S49°E 105.0'
4" J. PINE S34°W 127.7'

3" PIPE C. EUGENE OSTLING 1971
LCRC LIBER 1, PAGE 166
WIT: 16" N. PINE N44°30'E 83.7'
8" J. PINE S49°E 105.0'
6" J. PINE S34°W 127.7'

NORMAN F. PARKER, MARCH 1973
3" PIPE IN SEC. COR.
WIT: 16" N. PINE N44°E 83.7'
S.E. COR FD T. N47°W 95.2'
8" J. PINE S49°E 105.0'

NORMAN F. PARKER, MAY 1973
3" PIPE IN SEC. COR.
WIT: SAME AS ABOVE

CARL F. ROSER 1995, LCRC L3, PG 217
FD CAPPED IRON - B. JONES
WIT: POWER POLE N42°W 49.98'
J. PINE N60°E 55.61'
P. POLE S41°W 84.56'
J. PINE S48°E 90.85'

B. Description of corner evidence found and/or method applied in restoring or reestablishing corner:

FOUND 1/2" CAPPED BAR B. JONES OVER 3" PIPE
FOUND SPIKE IN P. POLE N42°W 49.98'
FOUND SPIKE IN P. POLE S41°W 84.56'
FOUND SPIKE IN 8" J. PINE S48°E 90.85'
FOUND SPIKE IN 8" J. PINE N60°E 55.61'
SEE MAP IN DOSSIER

CRAWFORD COUNTY
PEER GROUP APPROVAL
DATE NOV 22, 1996

Marvin E. Myers
Marvin E. Myers, P.S.
County Surveyor

C. Description of monument for corner and accessories established to perpetuate locating the position of the corner:

SET STANDARD CRAWFORD COUNTY MONUMENT BRASS, STAMPED 1996-17614
WIT: P. POLE N42°W 49.44'
P. POLE S41°W 84.56'
8" J. PINE S48°E 90.85'
8" J. PINE N60°E 55.61'
CARSONITE POST SE 49.15'
THE BEST AVAILABLE EVIDENCE OF THE POSITION OF THE ORIGINAL CORNER.



Signed by Larry Cavanagh
Surveyor's Michigan License No. 17614

Date Nov. 29, 1996