

**SURVEY & REMONUMENTATION**

MAY 05 1997

**LAND CORNER RECORDATION CERTIFICATE**

Filing Requirement of Act 74, Mich. P.A. 1970

For corners in COMMISSION  
Crawford  
(County)

Located In:

Corner Code #

1. Public Land Survey

T 25N R 3W  
T 25N R 4W


A-8  
M-8

2. Property Controlling in Section

S T R  
S T R

3. Miscellaneous Property in Section

S T R  
S T R

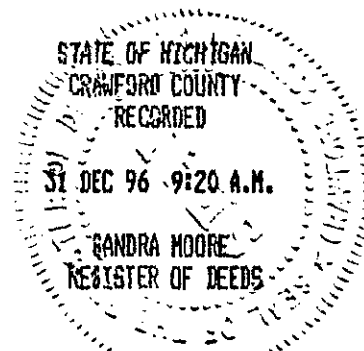

Register of Deeds Stamp & File Number

4. Lot No. \_\_\_\_\_, Recorded Plat \_\_\_\_\_

5. Private Claims \_\_\_\_\_

**LIBER 3 PAGE 243**

I, Larry L. Cavanagh, in a field survey on November, 1996, do hereby certify that under requirements of P.A. 74, Michigan P.A. of 1970, the corner points mentioned in lines 1 and 2 above were in conformance with regulations and rules therefore as required in the current manual of survey instructions of the United States Department of the Interior, Bureau of Land Management or by a decree of a Court of Law and/or that the corner points mentioned in lines 3, 4 and 5 above were in conformance with the rules of the Michigan Board of Professional Surveyors or by a Decree of a Court of Law; established, re-established, monumented, re-monumented, recovered, found as expressed below:

	A	B	C	D	E	F	G	H	I	J	K	L	M
2	6	5	4	3	2								
3													
4	7	8	9	10	11	12							
5													
6	18	17	16	15	14	13							
7													
8	19	20	21	22	23	24							
9													
10	30	29	28	27	26	25							
11													
12	31	32	33	34	35	36							
13													

**NOTE: Not more than 4 corners, all in the same town and range, may be recorded on this certificate.**

**A. Description of original monument and accessories and/or subsequent restoration:**

ADDISON BREWER 1852  
SET POST  
WIT: S. PINE 8" N50°15'W 553 LKS  
S. PINE 10" S28°15'W 616 LK S

CARL F. ROSER 1995  
LCRC L3, PG 2  
FD CAPPED IRON - B JONES #23514  
WIT: FD REROD S89°05'W 32.96'  
P. POLE S88°E 27.36'  
6" J. PINE S54°W 42.07'  
18" J. PINE N40°E 61.34'  
4" J. PINE N42°W 72.88'

GEORGE D. HENNING 1954  
SET 1/2" X 24" IRON  
11" J. PINE S83°W 58.50'  
14" J. PINE N36°E 61.0'  
10" J. PINE N31°W 104.0'

**B. Description of corner evidence found and/or method applied in restoring or reestablishing corner:**

FOUND 1/2" CAPPED BAR B. JONES BAR OVER 1/2" BAR  
FOUND NAIL IN POWER POLE N88°E 27.36'  
FOUND D.N.R. TAG IN 4" J. PINE N42°W 72.88'  
FOUND NAIL IN 6" J. PINE S54°W 42.07'  
FOUND NAIL IN 18" J. PINE N40°E 61.34'  
FOUND REROD S89°05'W 32.96'  
SEE MAP IN DOSSIER

**CRAWFORD COUNTY  
PEER GROUP APPROVAL  
DATE NOV 22, 1996**

*Marvin E. Myers*  
**Marvin E. Myers, P.S.  
County Surveyor**

**C. Description of monument for corner and accessories established to perpetuate locating the position of the corner:**

SET STANDARD CRAWFORD COUNTY MONUMENT BRASS, STAMPED 1996 #17614  
WIT: POWER POLE N88°E 27.36'  
4" J. PINE N48°W 73.88'  
10" J. PINE S48°W 42.07'  
18" J. PINE N34°E 61.34'  
CARSONITE POST NE 29.45'  
THE BEST AVAILABLE EVIDENCE OF THE POSITION OF THE ORIGINAL CORNER.



Signed by Larry L. Cavanagh  
Surveyor's Michigan License No. 17614

Date Nov. 29, 1996