

SURVEY & REMONUMENTATION

MAY 05 1997


COMMISSION

LAND CORNER RECORDATION CERTIFICATE
Filing Requirement of Act 74, Mich. P.A. 1970

For corners in Crawford
(County)

Located In:

Corner Code #

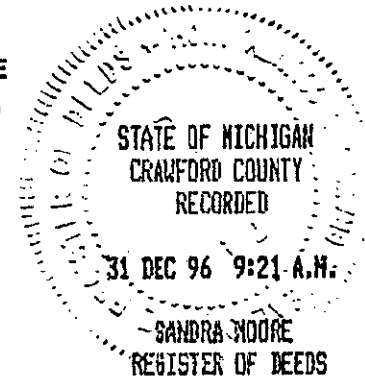

Register of Deeds Stamp & File Number

1. Public Land Survey	T	25N	R	3W	A-9 M-9
	T	25N	R	4W	
	T		R		
	T		R		
	T		R		
2. Property Controlling in Section	S		T	R	
	S		T	R	
3. Miscellaneous	S		T	R	
Property in Section	S		T	R	

4. Lot No. _____, Recorded Plat _____
5. Private Claims _____

LIBER 3 PAGE 246

A	B	C	D	E	F	G	H	I	J	K	L
2	6	5		4		3		2			
3											
4	7	8	9	10	11	12					
5											
6	18	17	16	15	14	13					
7											
8	19	20	21	22	23	24					
9											
10	30	29	28	27	26	25					
11											
12	31	32	33	34	35	36					
13											

I, Larry L. Cavanagh in a field survey on November, 1996, do hereby certify that under requirements of P.A. 74, Michigan P.A. of 1970, the corner points mentioned in lines 1 and 2 above were in conformance with regulations and rules therefore as required in the current manual of survey instructions of the United States Department of the Interior, Bureau of Land Management or by a decree of a Court of Law and/or that the corner points mentioned in lines 3, 4 and 5 above were in conformance with the rules of the Michigan Board of Professional Surveyors or by a Decree of a Court of Law; established, re-established, monumented, re-monumented, recovered, found as expressed below:

NOTE: Not more than 4 corners, all in the same town and range, may be recorded on this certificate.

A. Description of original monument and accessories and/or subsequent restoration:

POST SET BY ADDISON P. BREWER 1852
WIT: S. PINE 8" N33°W 25 LKS
Y. PINE 10" S72°W 27 LKS

FRANK ARLETH 1989
FOUND IRON IN BLACK TOP
WIT: 9" NORWAY N42°W 103.4'
10" J. PINE N40°E 104.8'
GUY POLE S52°E 48.5'

CARL F. ROSER 1995
LCRC L3, P217
FD 1 1/2" IRON BAR IN RD.
POWER POLE N60°E 49.71'
GUY POLE S48°E 48.80'
16" R. PINE S44°W 39.31'
STOP SIGN POST N04°W 51.47'

GEORGE D. HENNING 1954
1 1/8" X 36" STEEL BAR
9" NORWAY N42°W 103.4'
10" J. PINE N40°E 104.8'
GUY POLE S52°E 48.5'
6" J. PINE N46°E 106.6'

B. Description of corner evidence found and/or method applied in restoring or reestablishing corner:

FOUND 1 1/4" X 3" IRON ROD 3 FEET SOUTH OF CENTERLINE OF FLETCHER RD ON THE WEST EDGE OF GRAVEL OF OAK RD.
FOUND STOP SIGN POST N04°W 51.47'
FOUND DNR AND M.S.H.D. TAGS IN 16" NORWAY S44°W 39.31'
FOUND DNR TAG IN GUY POLE S48°E 48.80'
FOUND DNR TAG IN POWER POLE N60°E 49.71'
FOUND 2" PIPE (18" DEEP) EAST 10.34'
SEE MAP IN DOSSIER

CRAWFORD COUNTY
PEER GROUP APPROVAL
DATE Nov 22, 1996

Marvin E. Myers
Marvin E. Myers, P.S.
County Surveyor

C. Description of monument for corner and accessories established to perpetuate locating the position of the corner:

SET STANDARD CRAWFORD COUNTY MONUMENT BRASS, STAMPED 1996 #17614
WIT: 18" NORWAY S39°E 39.31'
STOP SIGN POST N10°W 51.57'
POWER POLE N53°E 49.71'
GUY POLE S53°E 48.80'
CARSONITE POST SW 36.45'
THE BEST AVAILABLE EVIDENCE OF THE POSITION OF THE ORIGINAL CORNER.



Signed by Larry L. Cavanagh Date Nov. 29, 1996
Surveyor's Michigan License No. 17614