

SURVEY & REMONUMENTATION

MAY 05 1997

LAND CORNER RECORDATION CERTIFICATE
Filing Requirement of Act 74, Mich. P.A. 1970


For corners in COMMISSION
Crawford
 (County)

Located In:

Corner Code #

- 1. Public Land Survey T 25N R 3W
 T 25N R 4W
 T _____ R _____
 T _____ R _____
- 2. Property Controlling S _____ T _____ R _____
 in Section S _____ T _____ R _____
- 3. Miscellaneous S _____ T _____ R _____
 Property in Section S _____ T _____ R _____

A-12
M-12

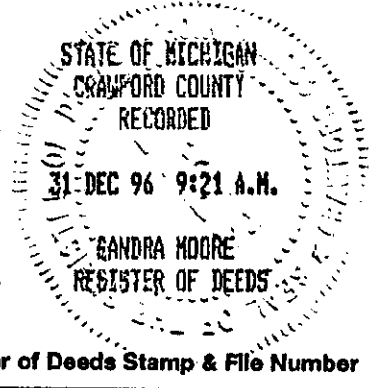

- 4. Lot No. _____, Recorded Plat _____
- 5. Private Claims _____

LIBER 3 PAGE 244

I, Larry L. Cavanagh, in a field survey on November, 19 96, do hereby certify that under requirements of P.A. 74, Michigan P.A. of 1970, the corner points mentioned in lines 1 and 2 above were in conformance with regulations and rules therefore as required in the current manual of survey instructions of the United States Department of the Interior, Bureau of Land Management or by a decree of a Court of Law and/or that the corner points mentioned in lines 3, 4 and 5 above were in conformance with the rules of the Michigan Board of Professional Surveyors or by a Decree of a Court of Law; established, re-established, monumented, re-monumented, recovered, found as expressed below:

A	B	C	D	E	F	G	H	I	J	K	L	M
2	0	5	4	3	2	1						
3												
4	7	8	9	10	11	12						
5												
6	16	17	18	15	14	13						
7												
8	19	20	21	22	23	24						
9												
10	30	29	28	27	26	25						
11												
12	31	32	33	34	35	36						
13												

NOTE: Not more than 4 corners, all in the same town and range, may be recorded on this certificate.

A. Description of original monument and accessories and/or subsequent restoration:

POST SET BY ADDISON P. BREWER 1852
 Y. PINE 15" N25°W 22 LKS
 W. OAK 12" S42°W 49 LKS

NORMAN PARKER 1979
 FD 1/2" BAR
 WIT: 16" B. OAK N26°45'E 44.4'
 10" B. OAK N60°W 92.1'

NORMAN F. PARKER 1984
 FD 1/2" BAR
 WIT: FACE P. POLE N54°W 58.4'
 16" OAK N26°45'E 44.4'
 10" OAK N60°W 92.10'

FRANK J. ARLETH 1974
 FD 1/2" BAR
 WIT: 16" B. OAK N26°45'E 44.4'
 10" B OAK N60°W 92.1'

NORMAN F. PARKER 1982
 CERT. OF SURVEY
 L209, P248
 NO WITNESSES

CARL R. JOHNSON 1987
 CERT. OF SURVEY
 NO CORNER MATERIAL NOTED

B. Description of corner evidence found and/or method applied in restoring or reestablishing corner:


FD 1/2" BAR CENTERLINE OF DORT RD AND EAST EDGE OF GRAVEL OAK RD.
 16" B. OAK N26°45'E 44.4'
 10" B. OAK N60°W 92.1'
 FD NEWER NAILS IN TREES WHICH LOOK LIKE MYER'S FLAGGING.
 SEE MAP IN DOSSIER

CRAWFORD COUNTY
PEER GROUP APPROVAL
 DATE NOV 22, 1996

Marvin E. Myers
Marvin E. Myers, P.S.
 County Surveyor

C. Description of monument for corner and accessories established to perpetuate locating the position of the corner:

SET STANDARD CRAWFORD COUNTY MONUMENT BRASS, STAMPED 1996 #17614
 WIT: 24" B. OAK N27°E 45.04'
 POWER POLE N57°W 57.98'
 18" B. OAK S60°W 81.11'
 10" NORWAY S33°E 58.79'
 CARSONITE POST SE 45.87'
 THE BEST AVAILABLE EVIDENCE OF THE POSITION OF THE ORIGINAL CORNER.

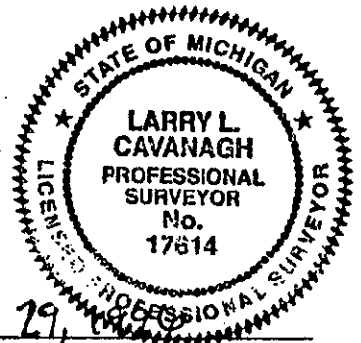

Signed by Larry L. Cavanagh
 Surveyor's Michigan License No. 17614

Date Nov 29, 1996