

LAND CORNER RECORDATION CERTIFICATE

FILING REQUIREMENT OF ACT 74, MICH. P.A.1970

FOR CORNERS OF--:	LOCATED IN--:	CORNER CODE NUMBER
1. PUBLIC LAND SURVEY _____	T. <u>25</u> N. R. <u>4</u>	<u>H-5</u>
2. PROPERTY CONTROLLING IN SECTION <u>10</u>	T. <u>25</u> N. R. <u>4</u>	<u>5</u>
3. MISCELLANEOUS PROPERTY IN SECTION <u>10</u>	T. <u>25</u> N. R. <u>4</u>	<u>H-4/5</u>
4. LOT NO. _____, RECORDED PLAT _____		
5. PRIVATE CLAIMS _____		

REGISTER OF DEEDS STAMP AND FILING NUMBER

I, Kenneth J. Ostling, do hereby certify that under requirements of P.A. 74, Michigan P.A. of 1970, the corner points mentioned in lines 1 and 2 above were, in a field survey on May 12, 1975, established, re-established, monumented, re-monumented, recovered or restored as expressed below and in conformance with regulations and rules therefore as required in the current manual of survey instructions of the United States Department of the Interior, Bureau of Land Management or by a decree of a court of law. Furthermore, that the corner points mentioned in lines 3, 4 and 5 above were, in a field survey on May 12, 1975, found, recovered, restored, established or re-established as expressed below and in conformance with the rules of the Michigan State Board of Registration for Land Surveyors or, by a Decree of a Court of law:

A. Description of original monument and accessories and/or subsequent restoration:


B. Description of corner evidence found and/or method applied in restoring or re-establishing corner:

- H-5 Set corner from probable U.S.B.T. stump.
- 5 Set by standard survey procedure for subdivision of sections.
- H-4/5 Set by standard survey procedure for subdivision of sections.

C. Description of monument for corner and accessories established to perpetuate locating the position of the corner:

H-5	5	H-4/5
Set DNR mon. & red-top post	Set 1"x30" Pipe & Cedar Post	Set 1" x 30" Pipe
7" R. Pine S73°E 28.9	2" R. Pine S70°E 17.2	9" Maple S08°W 71.1
5" W. Pine N75°E 39.8	2" W. Pine N40°W 32.85	20" R. Pine Stump
3" W. Pine S73°W 33.0	4" Beech N60°W 41.8	N87°E 23.3
W. Pine BT Stump		12" Tw. Maple S40°W 43.4
S63°E 19.8		

SIGNED BY *Kenneth J. Ostling*
 SURVEYOR'S MICHIGAN REGISTRATION NO. 10068

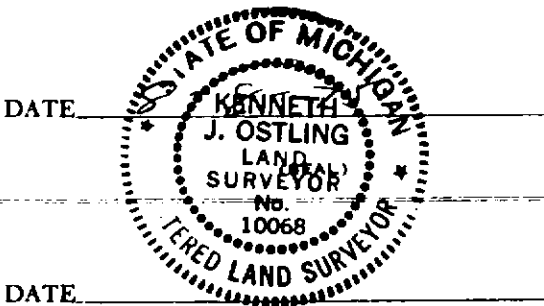

FOR STATE AND UNITED STATES AGENCIES:
 SIGNED BY _____ DATE _____
CHIEF OF SURVEY PARTY
 APPROVED AND SIGNED BY _____ DATE _____
MICHIGAN REGISTERED LAND SURVEYOR

SURVEYOR'S MICHIGAN REGISTRATION NO. _____