

LAND CORNER RECORDATION CERTIFICATE

FILING REQUIREMENT OF ACT 74, MICH. P.A.1970

FOR CORNERS OF --:	LOCATED IN --:	CORNER CODE NUMBER
1. PUBLIC LAND SURVEY _____	T. 25 N. ● R. 4 ● W.	D-6
2. PROPERTY CONTROLLING IN SECTION <u>17</u> _____	T. 25 N. ● R. 4 ● W.	5; 9; 11; 12
3. MISCELLANEOUS PROPERTY IN SECTION _____	T. _____ N. ● R. _____ E. ● W. ●	
4. LOT NO. _____, RECORDED PLAT _____		
5. PRIVATE CLAIMS _____		

REGISTER OF DEEDS STAMP AND FILING NUMBER

I, Kenneth J. Ostling, do hereby certify that under requirements of P.A. 74, Michigan P.A. of 1970, the corner points mentioned in lines 1 and 2 above were, in a field survey on October 19, 1978, established, re-established, monumented, re-monumented, recovered or restored as expressed below and in conformance with regulations and rules therefore as required in the current manual of survey instructions of the United States Department of the Interior, Bureau of Land Management or by a decree of a court of law. Furthermore, that the corner points mentioned in lines 3, 4 and 5 above were, in a field survey on _____, 19____, found, recovered, restored, established or re-established as expressed below and in conformance with the rules of the Michigan State Board of Registration for Land Surveyors or, by a Decree of a Court of law:

A. - Description of original monument and accessories and/or subsequent restoration:

C. (continued)

	11		12		
Set 5/8" Rod w/RLS Cap and cedar post			Set 5/8" Rod w/RLS Cap and cedar post		
4" J. Pine N10°W 2.1			18" R. Pine S23°E 42.25		
7" J. Pine N67°E 17.15			6" Twn. Oak S18°W 7.79		

B. Description of corner evidence found and/or method applied in restoring or re-establishing corner:


- D-6 Set corner at intersection of true 1/4 lines, per standard survey procedure for the subdivision of sections.
- 5 Set by standard survey procedure for section subdivision.
- 9 Set by standard survey procedure for section subdivision.
- 11 Set corner by standard survey procedure for the subdivision of sections.
- 12 Set by standard survey procedure for the subdivision of sections.

C. Description of monument for corner and accessories established to perpetuate locating the position of the corner:

	D-6		5		9
5/8" rod w/RLS Cap & Cedar Post			Set 5/8" Rod w/RLS Cap and cedar post		Set 5/8" Rod w/RLS Cap & cedar post
4" R. Pine N86°E 14.68			4" R. Oak N18°E 12.32		10" Oak S80°W 14.81
4" R. Pine N14°E 26.55			5" W. Oak N75°E 17.00		11" Maple N37°W 37.88

SIGNED BY Kenneth J. Ostling
 SURVEYOR'S MICHIGAN REGISTRATION NO. 10068

DATE 11-15-78

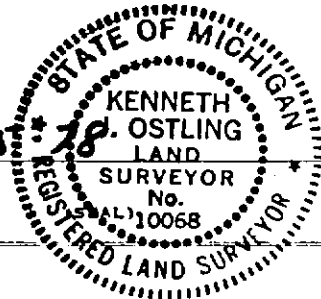

FOR STATE AND UNITED STATES AGENCIES:

SIGNED BY _____ DATE _____
CHIEF OF SURVEY PARTY

APPROVED AND SIGNED BY _____ DATE _____
MICHIGAN REGISTERED LAND SURVEYOR

(SEAL)

SURVEYOR'S MICHIGAN REGISTRATION NO. _____ CRAWFORD COUNTY