

LAND CORNER RECORDATION CERTIFICATE

FILING REQUIREMENT OF ACT 74, MICH. P.A.1970

FOR CORNERS OF--:	LOCATED IN--:	CORNER CODE NUMBER
1. PUBLIC LAND SURVEY _____	T. 25 N. R. 4 W. ●	C-5; C-6; D-5; E-5
2. PROPERTY CONTROLLING IN SECTION _____	T. _____ N. R. _____ W. ●	_____
3. MISCELLANEOUS PROPERTY IN SECTION _____	T. _____ N. S. R. _____ E. W. ●	_____
4. LOT NO. _____, RECORDED PLAT _____		
5. PRIVATE CLAIMS _____		

REGISTER OF DEEDS STAMP AND FILING NUMBER

I, Kenneth J. Ostling, do hereby certify that under requirements of P.A. 74, Michigan P.A. of 1970, the corner points mentioned in lines 1 and 2 above were, in a field survey on September 25, 1978, established, re-established, monumented, re-monumented, recovered or restored as expressed below and in conformance with regulations and rules therefore as required in the current manual of survey instructions of the United States Department of the Interior, Bureau of Land Management or by a decree of a court of law. Furthermore, that the corner points mentioned in lines 3, 4 and 5 above were, in a field survey on _____, 19____, found, recovered, restored, established or re-established as expressed below and in conformance with the rules of the Michigan State Board of Registration for Land Surveyors or, by a Decree of a Court of law:

~~A. - Description of original monument and accessories and/or subsequent restoration:~~

C. (continued)

E-5

Fd. stake pt.-set DNR mon. & cedar post	
14" W. Oak N33°E	13.5
12" R. Pine S81°E	50.25
USBT W. Pine Stump N63°E	16.15
Old NBT Pine Stump N18°W	10.2
Old NBT Pine Stump N70°E	39.0


B. Description of corner evidence found and/or method applied in restoring or re-establishing corner:

- C-5 Set corner from possible USBT stump, YP14 N81-45E 514.8'. No evidence of a previous corner in this area.
- C-6 Set corner by proportionate measurement, midpoint on line, between section corners. No previous corner.
- D-5 Set by proportionate measurement, midpoint on line, between section corners. No previous corner.
- E-5 Found old stake point in place as prescribed by USBT stumps. Previously located by E. S. Houghton. Good original corner.

C. Description of monument for corner and accessories established to perpetuate locating the position of the corner:

C-5	C-6	D-5
Set DNR monument	Set DNR Monument	Set DNR Mon. & Cedar Post
8" J. Pine S10°E 94.0	4" J. Pine N79°W 24.75	5" Maple Clstr. S24°W 13.25
7" J. Pine S42°E 55.84	3" J. Pine N55°E 30.05	8" R. Oak S77°E 20.7
Cedar Post East 25	Cedar Post East 16	

SIGNED BY *Kenneth Ostling*
 SURVEYOR'S MICHIGAN REGISTRATION NO. 10068

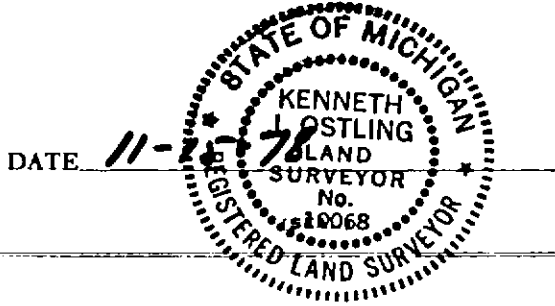

FOR STATE AND UNITED STATES AGENCIES:

SIGNED BY _____ DATE _____
CHIEF OF SURVEY PARTY

APPROVED AND SIGNED BY _____ DATE _____
MICHIGAN REGISTERED LAND SURVEYOR

SURVEYOR'S MICHIGAN REGISTRATION NO. _____ CRAWFORD COUNTY