LAND CORNER RECORDATION CERTIFICATE
Filing Requirement of Act 74, Mich. P.A. 1970

For corners in CRAWFORD (County)

	Located In:	Corner Code #1
1. Public Land Survey	T 25N R 4W	L-9
	T ___ R ___	
	T ___ R ___	
	T ___ R ___	
2. Property Controlling in Section	S 25 T ___ R ___	7, 10
	S ___ T ___ R ___	
3. Miscellaneous Property in Sec.	S ___ T ___ R ___	
	S ___ T ___ R ___	

Register of Deeds Stamp & File Number

4. Lot No. _____, Recorded Plat _____
5. Private Claims _____

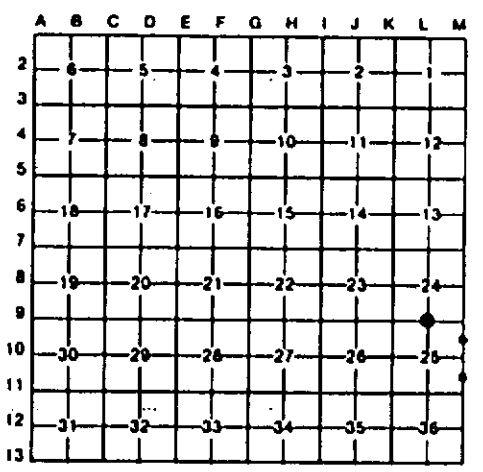

I, CARL F. ROSER, in a field survey on JULY 13, 19 94, do hereby certify that under requirements of P.A. 74, Michigan P.A. of 1970, the corner points mentioned in lines 1 and 2 above were in conformance with regulations and rules therefore as required in the current manual of survey instructions of the United States Department of the Interior, Bureau of Land Management or by a decree of a Court of Law and/or that the corner points mentioned in lines 3, 4 and 5 above were in conformance with the rules of the Michigan Board of Land Surveyors or by a Decree of a Court of Law; established, re-established, monumented, re-monumented, recovered, found as expressed below:

NOTE: Not more than 4 corners, all in the same town and range, may be recorded on this certificate.

A. Description of original monument and accessories and/or subsequent restoration:

L-9 (NO EVIDENCE OF G.L.O. CORNER, B.T'S. INE TREES AND TOPOGRAPHY AS CALLED OUT IN THE G.L.O. LINE NOTES; UNLESS NOTED IN ITEM "B" BELOW.)

7

10

B. Description of corner evidence found and/or method applied in restoring or reestablishing corner:

L-9: ACCEPTED FD REROD FOR N 1/4 COR SEC 25. COR FITS MIDWAY & ON LINE BETWEEN FD SEC CORS 1/2 MILE E & W. FD 2" PIPE (PROBABLY CONSERVATION DEPT SURVEYOR M.SCHAAF-1944) IS S11°56'E, 22.65'; DID NOT ACCEPT M.SCHAAF PIPE. (SCHAAF SET 1/4 COR BY PROPORTIONATE MEAS.).

7: FD F.J. ARLETHS IRON FOR NE COR OF SE 1/4 OF SE 1/4 OF SEC 25. CTR OF N-S GRAVEL ROAD (OAK RD) IS 21' EAST.

10: FD REROD FOR NE COR OF SE 1/4 OF SE 1/4 OF SEC 25. COR FITS MIDWAY & ON LINE BETWEEN FD 1/4 COR TO N & FD SEC COR SOUTH.

C. Description of monument for corner and accessories established to perpetuate locating the position of the corner:

L-9: FD. 5/8" REROD 0.8' DEEP.

8" W PINE	N26°W	22.84'
4" OAK	N55°E	22.53'
TOP CENTER TELEPHONE BOX	S58°W	85.02'
22" R PINE	S53°W	107.66'
C/L E-W B.TOP	SOUTH	15.7'

7: FD. 1/2" IRON WITH CAP #21266.

POWER POLE	S42°E	66.56'
5" J PINE	S23°W	22.25'
11" J PINE	N69°W	11.29'
12" J PINE	N83°W	59.11'

10: 1/2" REROD.

POWER POLE	S85°W	47.74'
GUY POLE	S37°W	17.60'
14" J PINE	N85°E	68.49'
14" R PINE	N35°W	25.93'
C/L OAK RD	EAST	19'
C/L TRAIL RD	WEST	EXTENDED

STATE OF MICHIGAN — CARL F. ROSER LAND SURVEYOR No. 12028 — REGISTERED LAND SURVEYOR

Signed by Carl F. Roser Date 6-29-95

Surveyor's Michigan License No. 12028

FORM APPROVED BY MICHIGAN STATE BOARD OF LAND SURVEYORS, JAN. 28, 1971
REVISED MAY 14, 1975
REVISED JAN., 1983