

**SURVEY &
RECORDS DOCUMENTATION**

MAR 29 2000

**LAND CORNER RECORDATION CERTIFICATE
Filing Requirement of Act 74, Mich. P.A. 1970**

SECTION _____

For corners in

Crawford

(County)

Located In:

Corner Code #

- | | | |
|------------------------------------|--------------------------|-------------|
| 1. Public Land Survey | T _____ R _____ | _____ |
| | T <u>25N</u> R <u>4W</u> | <u>A-13</u> |
| | T _____ R _____ | _____ |
| | T _____ R _____ | _____ |
| 2. Property Controlling in Section | S _____ T _____ R _____ | _____ |
| | S _____ T _____ R _____ | _____ |
| 3. Miscellaneous Property in Sec. | S _____ T _____ R _____ | _____ |
| | S _____ T _____ R _____ | _____ |

STATE OF MICHIGAN
CRAWFORD COUNTY
RECORDED

17 AUG 99 12:29 P.M.

SANDRA MOORE
REGISTER OF DEEDS

Register of Deeds Stamp & File Number

4. Lot No. _____, Recorded Plat _____
5. Private Claims _____

LIBER 4 PAGE 05

I, Marvin E. Myers, in a field survey on March, 1999 do hereby state that under requirements of P.A. 74, Michigan P.A. of 1970, the corner points mentioned in lines 1 and 2 above were in conformance with regulations and rules therefore as required in the current manual of survey instructions of the United States Department of the Interior, Bureau of Land Management or by a decree of a Court of Law and for that the corner points mentioned in lines 3, 4 and 5 above were in conformance with the rules of the Michigan Board of Land Surveyors or by a Decree of a Court of Law; established, re-established, monumented, recovered, found as expressed below:

| | | | | | | | | | | | | | |
|----|----|----|----|----|----|----|---|---|---|---|---|---|---|
| 1 | A | B | C | D | E | F | G | H | I | J | K | L | M |
| 2 | 6 | 5 | 4 | 3 | 2 | 1 | | | | | | | |
| 3 | | | | | | | | | | | | | |
| 4 | 7 | 8 | 9 | 10 | 11 | 12 | | | | | | | |
| 5 | | | | | | | | | | | | | |
| 6 | 18 | 17 | 16 | 15 | 14 | 13 | | | | | | | |
| 7 | | | | | | | | | | | | | |
| 8 | 19 | 20 | 21 | 22 | 23 | 24 | | | | | | | |
| 9 | | | | | | | | | | | | | |
| 10 | 30 | 29 | 28 | 27 | 26 | 25 | | | | | | | |
| 11 | | | | | | | | | | | | | |
| 12 | 31 | 32 | 33 | 34 | 35 | 36 | | | | | | | |
| 13 | | | | | | | | | | | | | |

NOTE: Not more than 2 corners, all in the same town and range, may be recorded on this certificate.

A. Description of original monument and accessories and/or subsequent restoration:

G.L.O - 1839 John Brink, DS
Mon - Post
Wit: 10" B. Oak N66°W 10 lks.
10" W. Oak N38°E 20 lks.

Marcus Schaaf 1940's
Mon: Iron Set

G.L.O. - Aug 1852 Geo. H. Cannon, DS
Mon - Post
Wit: None given

LCRC L1 P 199 Missaukee Co. Records
Sept 17, 1974 Herbert L. Fluharty #18223
Mon - 1 1/2" pipe
Wit: 14" Oak S72°W 59.85
15" Oak S44°E 58.00
8" R. Pine N28°E 69.75

B. Description of corner evidence found and/or method applied in restoring or reestablishing corner:


Found Schaaf 1 1/2" pipe in concrete. Found 18" Norway N35°E 69.64
Accepted pipe as the best available evidence of the position of the Original Corner. Replaced pipe with Standard Crawford County Monument.

C. Description of monument for corner and accessories established to perpetuate locating the position of the corner:

Mon: Standard Crawford County Corner 0.5' below surface.
Wit: Nail E. side 18" Norway N35°E 69.64
Carsonite Post N67°E 46.26
Nail S. side 16" Twin Maple S55°E 74.84
Nail N. side 7" B. Oak S76°W 66.86

**CRAWFORD COUNTY
PEER GROUP APPROVAL
DATE June 7, 1999**

Marvin E. Myers M.E.S.
**Marvin E. Myers, P.S.
County Surveyor**

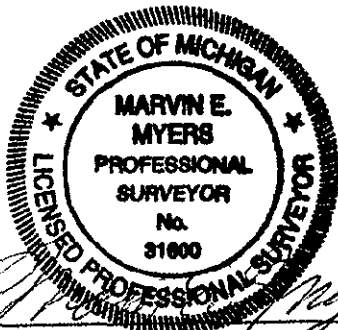

Signed by _____
Surveyor's Michigan License No. 31800

Date June 8, 1999