

LAND CORNER RECORDATION CERTIFICATE

Filing Requirement of Act 74, Mich. PA 1970

For Corners In: Crawford Located In _____ Corner Code # _____
(County)

- | | | | | | |
|--------------------------------------|---|------------|---|-----------|------------|
| 1. Public Land Survey | T | <u>26N</u> | R | <u>1W</u> | <u>C-6</u> |
| | T | _____ | R | _____ | _____ |
| 2. Property Controlling in Section | S | _____ | T | _____ | _____ |
| | S | _____ | T | _____ | _____ |
| 3. Miscellaneous Property in Section | S | _____ | T | _____ | _____ |
| | S | _____ | T | _____ | _____ |


4. Lot No: _____ Recorded Plat: _____

5. Private Claims: _____

I, Carl T. Kiiskila, in a field survey on November 18, 2006 do hereby state that under requirements of PA 74, Michigan PA of 1970, the corner points mentioned in lines 1 and 2 above were in conformance with regulations and rules therefore as required in the current manual of survey instructions of the United States Department of the Interior, Bureau of Land Management or by a decree of a Court of Law and/or that the corner points mentioned in lines 3, 4 and 5 above were in conformance with the rules of the Michigan Board of Land Surveyors or by a Decree of a Court of Law; established, re-established, monumented, recovered, found as expressed below:

NOTE: Not more than 2 corners, all in the same town and range, may be recorded on this certificate.

Register of Deeds Stamp & File Number

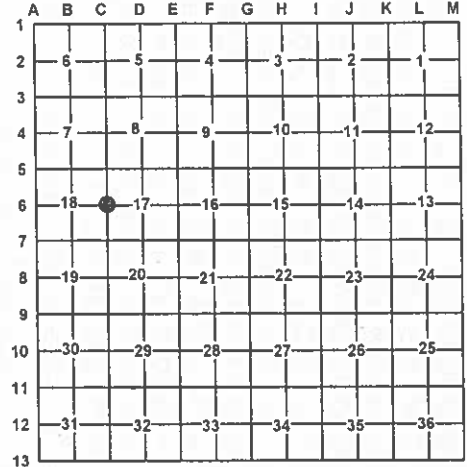

A. Description of original monument and accessories and/or subsequent restoration:

- | | |
|--|---|
| C-6 G.L.O. 1852 D. A. Pettibone set post for quarter corner.
Wit: 9" Poplar N61°W 22 links
7" Poplar N70°E 13 ½ links | June 1967 Robert Griffin RLS #13584 found rotted wood stake set by G.D. Henning and replaced it with 6" concrete monument.
Wit: 4" Square Post North 1.7'
4" Ash N32°E 55.10'
2" Pipe East 1.0'
11" Cedar S60°E 90.22'
8" Maple S16°W 65.65'
16" Cedar N32°W 39.41' |
| 1909 Fargo Engineering found USBT
Wit: 10" Sp. Pine S21°W 27 links
12" S. Maple N62 ½° E 26 links | |
| 1963 George D. Henning RLS #2240 found Cedar Post one foot West of 2" pipe.
Wit: 18" Elm N85°E 11.7'
16" Cedar N23°W 38.6' | |

B. Description of corner evidence found and/or method applies in restoring or re-establishing corner:

C-6 Found Concrete Monument

C. Description of monument for corner and accessories established to perpetuate locating the position of the corner:

- C-6 Found Concrete Monument
- | | | |
|----------------|-------|--------|
| Wit: 12" Maple | S22°W | 65.67' |
| 18" Cedar | N50°E | 39.45' |
| 2" Pipe | East | 0.80' |
| 18" Cedar | N70°E | 90.35' |
| 6" Balsam | N79°W | 25.08' |



Signed by: Carl T. Kiiskila

Date: 2-5-07

Surveyor's Michigan License No.: 33981