PAGE

CRAWFORD COUNTY REMONUMENTATION


LAND CORNER RECORDATION CERTIFICATE

STATE OF MICHIGAN COUNTY OF CRAWFORD

Eο	or corners in	Filing Requirement of Act 74, Mich. P.A. 1970				COORT OF CRAFF ORD							
						FILED FOR RECORD THIS THE DAY OF 1993 AT							
Crawford (County)		Located I	in: Corne	er Code ##	\propto /	DAY OF	1)C	., 191	12AI	ī			
		07.0	313 h _	6	3:00	am/fm	, IN LIE	3ER_	3				
1.	Public Land Survey	T 20N	T <u>26N</u> R <u>1W</u> A - 9 T R					PAGE					
					· <u>-</u>	gister of	W. W. C.	Viels	incl	-			
2.	Property Controlling	S T	_ R		Re	gister of	Deeds						
	in Section	S T	_ R										
3.	Miscellaneous	S T	_ R <u> </u>		legister of	Deeds S	itamp (& File	Num	ber			
	Property in Sec.	S T	_ R	:	· <u> </u>	·							
						i							
				·	<u>A B</u>	¢ 0	E f	в н	1 1	K	L A		
5.	Private Claims		<u> </u>		2 6-		_ _	 3-	<u> </u>		_		
					3			<u> </u>	1-1				
					4	_ _ 	_ <u> </u>	10-		,	 -12-		
1.	Marvin E. Myers	. in a field survey or	n <u>December</u>	, 19 _93	5	<u> </u>	<u> </u>	LĨ			Ï.		
do	hereby certify that under	requirements of P.A. 74, I	Michigan P.A. of 1970, the	corner points mentioned	6 18						-13		
			egulations and rules there		7	\Box	Ĭ	Ĭ			Ĭ		
			States Department of the that the corner points men		8 10				TJ	T	Ţ		
ab	ove were in conformance	with the rules of the Micl	higan Board of Land Surve	eyors or by a Decree of a	و ا	1 20	27	-22-	7-2	Ť	-2 a		
Co	ourt of Law; established	l, re-established, monu	imented, re-monumented	I, recovered, found as	10 30	11-					<u> </u>		
	pressed below:				30	29	28	27-	1-26	,	-25— Ì		
N			ame town and range, n	nay be recorded	11	+ +	 		+-1	\top	+-		
	on this certifica	te.			12 -31-	32	33	3'4-		5—	-36-		
			essories and/or subsec	Oct 1970 N.	Darker								
	ILO - April 1839 J.Mu Ion Post		M.E.Myers - 12" Pipe	Mon- ½" bar		tion Pa	ost						
	PIT: 6" Pine N47°W 22		½" Bar N41°W 78.86'	(Note: Conse			no reco	ord o	f su	rvey	in		
	8" Pine S86°W 20	lks.	3/4" Pipe N6°E 56.85	this area ac				_		1			
_	GLO - June 1853 D.A.F	ettibone	S11°W 56.58'	R.Pine Sept 1971 US USFS did not	FS place I	ocation this:	n tag a section	along n.	side	₹" i	bar		
	lon Fd. Post & BTS NIT: 6" Pine N242W 2.	i 74 che	Spike in side of 10	USFS did not " Oak N50°E 92.80"				_					
W	6" Pine N8½°E 2.	17 oha ***	909 Fargo Engineering on- Set monument	1224 P.533 C Mon- 1½ ⁿ pip									
				g M-72	South 4'± er NOO°22'	1302 20	635 06						

B. Description of corner evidence found and/or method applied in restoring or reestablishing corner:

Found 1½" pipe 8 inches below surface of asphalt 5 feet North of centerline of M-72 verified position by measurement to accessories and corners of record and accepted as the best available evidence of the original corner.

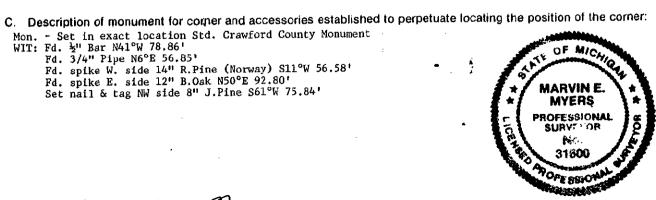

Signed by Marvin E. Myen	DateDecember 21, 1993
Surveyor's Michigan License No. 31600	FORM APPROVED BY MICHIGAN STATE BOARD OF LAND SURVEYORS, JAN. 28, 19 REVISED MAY 14, 19
DATE December 13, 1993 PEER GROUP APPROVAL	REVISED JAH., 19