

STATE OF MICHIGAN
DEPARTMENT
OF
NATURAL RESOURCES

LAND CORNER RECORD

CRAWFORD COUNTY


T 26 N R 1 W

DESCRIPTION OF CORNER South 1/16 corner on N-S 1/4 line, Sec. 31

CORNER MONUMENT Set 2' of 1" pipe

DATE MONUMENT PLACED AND WITNESSED 12-3-71

WITNESSES TO CORNER.....

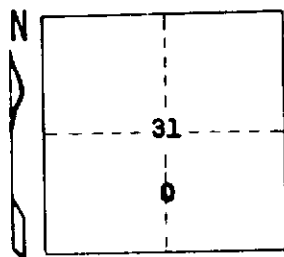

4" R. Pine N 55 E 11.6'


7" R. Pine N 87 W 10.95'

AND

CIRCLE CORNER REGISTERED

DESCRIPTION IN DETAIL AS TO HOW CORNER WAS LOCATED AND IDENTIFIED OR RESTORED.

Set by standard survey procedure for subdivision of sections.

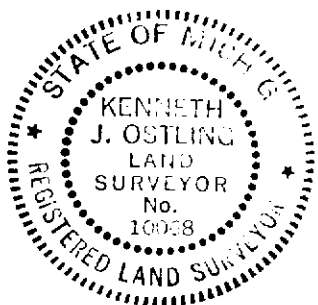

SURVEYOR'S SEAL

SIGNED

Kenneth J. Ostling
REGISTERED LAND SURVEYOR

DATE

12-10-71

10068

DISTRIBUTION:

County Courthouse
Area Forester (Regions I & II)
District or Region Surveyor
Forestry Div., Lansing

R 4047
Rev. 10/68