

STATE OF MICHIGAN
DEPARTMENT
OF
NATURAL RESOURCES

LAND CORNER RECORD


CRAWFORD COUNTY
T 26 N R 1 W

DESCRIPTION OF CORNER N. W. Section corner

CORNER MONUMENT Set Dept. Monument

DATE MONUMENT PLACED AND WITNESSED 11-29-71

WITNESSES TO CORNER..... 6" Bl. Oak N 58 W 13.4'

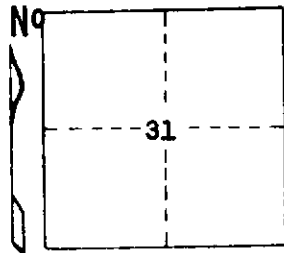

4" Bl. Oak N 40 E 3.9'

4" J. Pine S 02 E 8.7'


AND

Red Pine 2 ft. tall S 62 E 1.8'

CIRCLE CORNER REGISTERED

DESCRIPTION IN DETAIL AS TO HOW CORNER WAS LOCATED AND IDENTIFIED OR RESTORED.

Corner set by proportionate measurement between section corners 1 mile North and South. A wood post, about 45' SE does not appear to be related to other existing corners in this vicinity, and was disregarded.

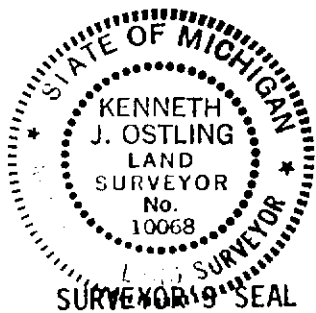

SIGNED

Kenneth J. Ostling
REGISTERED LAND SURVEYOR 10068

DATE 12-6-71

DISTRIBUTION:

County Courthouse
Area Forester (Regions I & II)
District or Region Surveyor
Forestry Div., Lansing

R 4047
Rev. 10/68