

STATE OF MICHIGAN
DEPARTMENT
OF
NATURAL RESOURCES

LAND CORNER RECORD


CRAWFORD COUNTY
T 26 N R 1 W

DESCRIPTION OF CORNER West 1/4 corner

CORNER MONUMENT Set Dept. Monument

DATE MONUMENT PLACED AND WITNESSED 9-27-71

WITNESSES TO CORNER..... 2" R. Pine N 37 E 9.0'

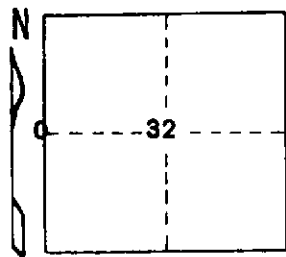

6" R. Pine N 33 E 52.0'

9" R. Pine S 82 W 17.1'


AND

CIRCLE CORNER REGISTERED

DESCRIPTION IN DETAIL AS TO HOW CORNER WAS LOCATED AND IDENTIFIED OR RESTORED.

No evidence of old corner found

Set Dept. Monument M.P.O.L. between the NW and SW section corners of Sec. 32.

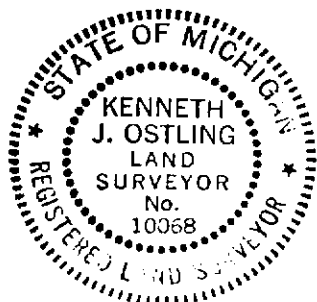

SURVEYOR'S SEAL

SIGNED

Kenneth J. Ostling
REGISTERED LAND SURVEYOR 10068

DATE 10-4-71

DISTRIBUTION:

County Courthouse
Area Forester (Regions I & II)
District or Region Surveyor
Forestry Div., Lansing

R 4047
Rev. 10/68