

STATE OF MICHIGAN  
DEPARTMENT  
OF  
NATURAL RESOURCES

LAND CORNER RECORD


CRAWFORD COUNTY  
T 26 N R 1 W

DESCRIPTION OF CORNER S 1/16 on N-S 1/4 line

CORNER MONUMENT Set 2' of 1" pipe

DATE MONUMENT PLACED AND WITNESSED 10-11-71

WITNESSES TO CORNER..... 9" B. Oak N 43 W 31.4'

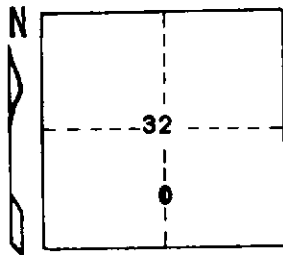


10" W. Oak N 37 E 12.4'

AND

CIRCLE CORNER REGISTERED

DESCRIPTION IN DETAIL AS TO HOW CORNER WAS LOCATED AND IDENTIFIED OR RESTORED.

Set M.P.O.L. between center post and S 1/4 corner of Section 32.

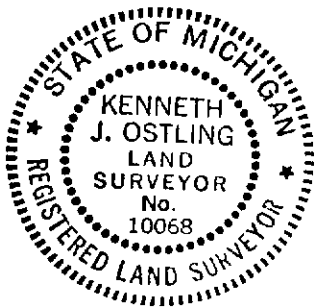

SURVEYOR'S SEAL

SIGNED

*Kenneth J. Ostling*  
REGISTERED LAND SURVEYOR  
10068

DATE 10-11-71

DISTRIBUTION:

County Courthouse  
Area Forester (Regions I & II)  
District or Region Surveyor  
Forestry Div., Lansing

R 4047  
Rev. 10/68