


STATE OF MICHIGAN
DEPARTMENT
OF
NATURAL RESOURCES

LAND CORNER RECORD

✓
_____CRAWFORD_____COUNTY
T 26 N R 1 W

DESCRIPTION OF CORNER Center 1/4 corner of Sec. 32
CORNER MONUMENT Set 2' x 1" pipe
DATE MONUMENT PLACED AND WITNESSED 10-5-71
WITNESSES TO CORNER.....

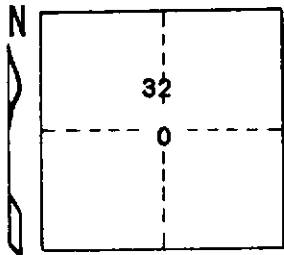


6" Balsam S 51 W 16.6'
9" Balsam N 22 W 16.0'
AND

CIRCLE CORNER REGISTERED

DESCRIPTION IN DETAIL AS TO HOW CORNER WAS LOCATED AND IDENTIFIED OR RESTORED.

Set at intersection of N-S E-W 1/4 lines.

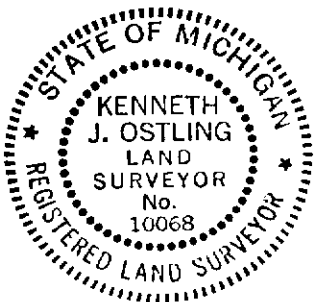

SURVEYOR'S SEAL

DISTRIBUTION:

SIGNED Kenneth J. Ostling DATE 10-12-71
REGISTERED LAND SURVEYOR
10068

County Courthouse
Area Forester (Regions I & II)
District or Region Surveyor
Forestry Div., Lansing

R 4047
Rev. 10/68