

LAND CORNER RECORDATION CERTIFICATE
Filing Requirement of Act 74, Mich. P.A. 1970

or corners in
Crawford Located In: Corner Code 11
(County)

Public Land Survey T 26N R 1W C-2
T _____ R _____
T _____ R _____
T _____ R _____
T _____ R _____

Property Controlling S _____ T _____ R _____
In Section S _____ T _____ R _____
Miscellaneous S _____ T _____ R _____
Property In Sec. S _____ T _____ R _____

STATE OF MICHIGAN
COUNTY OF CRAWFORD

FILED FOR RECORD THIS
6th DAY OF June 1990 AT
9:30 (a.m./p.m.) in LIBER 2
PAGE 386
Elizabeth D. Wisland
Register of Deeds

Register of Deeds Stamp & File Number

Lot No. _____ Recorded Plat _____
Private Claims _____

	A	B	C	D	E	F	G	H	I	J	K	L	M
2	6	5	4	3	2	1							
3													
4	7	8	9	10	11	12							
5													
6	18	17	16	15	14	13							
7													
8	19	20	21	22	23	24							
9													
10	30	29	28	27	26	25							
11													
12	31	32	33	34	35	36							
13													

Norman C. Caldwell in a field survey on March 1990
I hereby certify that under requirements of P.A. 74, Michigan P.A. of 1970, the corner points mentioned in lines 1 and 2 above were in conformance with regulations and rules therefore as required in the current manual of survey instructions of the United States Department of the Interior, Bureau of Land Management or by a decree of a Court of Law and/or that the corner points mentioned in lines 3, 4 and 5 above were in conformance with the rules of the Michigan Board of Land Surveyors or by a Decree of a Court of Law; established, re-established, monumented, re-monumented, recovered, found as expressed below:

NOTE: Not more than 4 corners, all in the same town and range, may be recorded on this certificate.

Description of original monument and accessories and/or subsequent restoration:


- (C-2) Post set by Pettibone, June 12, 1852.
Tamarack 5" N24°W .08 (5.28')
Cedar 12" S72°W .51 (33.66')

Description of corner evidence found and/or method applied in restoring or reestablishing corner:

- (C-2) DNR pipe & cap placed from original BT 12-2-54.
N09°E 28.4' 8" Cedar
S01°E 44.2' 14" W. Birch

Description of monument for corner and accessories established to perpetuate locating the position of the corner:

- (C-2) 1/4 cor. 5&6, T26N-R1W
Fnd. DNR pipe & cap. And is accepted as a careful & faithful perpetuation of the position of the original corner.
North 1.0' Carsonite Witness Post
N14°E 28.4' 12" Cedar (R)
N40°W 23.1' 8" Cedar
S60°W 43.7' 14" Red Maple
S06°E 41.0' 13" Red Maple

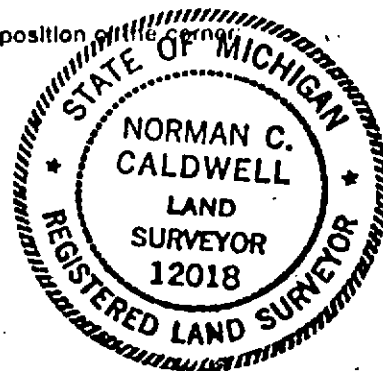

Signed by Norman C. Caldwell Date April 26, 1990

Surveyor's Michigan License No. 12018