

LIBER

2 PAGE 387

LAND CORNER RECORDATION CERTIFICATE
Filing Requirement of Act 74, Mich. P.A. 1970.

STATE OF MICHIGAN
COUNTY OF CRAWFORD

or corners in

Crawford
(County)

Located In:

Corner Code: #

Public Land Survey

T 26N R 1W

C-3

T R

T R

T R

T R

Property Controlling

S T R

In Section

S T R

Miscellaneous

S T R

Property in Sec.

S T R

FILED FOR RECORD THIS
6th DAY OF June, 1990 AT
9:30 AM, IN LIBER 2
PAGE 387.

E. J. ...
Register of Deeds

Register of Deeds Stamp & File Number

Lot No. _____, Recorded Plat _____

Private Claims _____

	A	B	C	D	E	F	G	H	I	J	K	L	M
2	8	5	4	3	2	1							
3		●											
4	7	8	9	10	11	12							
5													
6	18	17	16	15	14	13							
7													
8	19	20	21	22	23	24							
9													
10	30	29	28	27	26	25							
11													
12	31	32	33	34	35	36							
13													

Norman C. Caldwell in a field survey on March, 1990.

I hereby certify that under requirements of P.A. 74, Michigan P.A. of 1970, the corner points mentioned in lines 1 and 2 above were in conformance with regulations and rules theretore as required in the present manual of survey instructions of the United States Department of the Interior, Bureau of Land Management or by a decree of a Court of Law and/or that the corner points mentioned in lines 3, 4 and 5 above were in conformance with the rules of the Michigan Board of Land Surveyors or by a Decree of a Court of Law, established, re-established, monumented, re-monumented, recovered, found as pressed below:


NOTE: Not more than 4 corners, all in the same town and range, may be recorded on this certificate.

Description of original monument and accessories and/or subsequent restoration:

- C-3) Post set by Pettibone, June 12, 1852.
Pine 18" N34°W .54 (35.64')
- Pine 18" S73°E .35 (23.10')

Description of corner evidence found and/or method applied in restoring or reestablishing corner:

- C-3) DNR pipe & cap placed from 2 original BTs April 14, 1954.
N55°E 22.0' 14" J. Pine
S30°W 35.0' 8" W. Pine
N50°W 33.0' 14" R. Oak

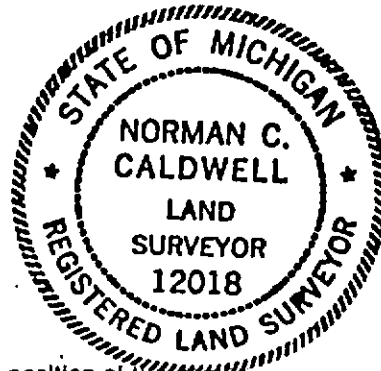

Description of monument for corner and accessories established to perpetuate locating the position of the corner:

- C-3) Sec. cor. 5, 6, 7, & 8, T26N-RLW
Fnd. DNR pipe & cap with U.S. BTs SE & SW. And is accepted as a careful & faithful perpetuation of the position of the original corner.
North 1' Carsonite Witness Post N80°E 39.9' 16" Oak (Red)
N50°E 22.0' 14" J. Pine (R) S60°W 35.6' 18" Pine stump (orig. BT)
S30°W 35.4' 17" W. Pine (R) S73°E 23.1' 18" Pine stump (orig. BT)
S82°W 41.5' 5" R. Pine
N44°W 33.8' 20" Twin Oak (R)

NOTE: Orig. BT N34°W is fnd. well marked & bearing S60°W

Witnessed by *Norman C. Caldwell*

Date April 26, 1990

Surveyor's Michigan License No. 12018