

LAND CORNER RECORDATION CERTIFICATE
Filing Requirement of Act 74, Mich. P.A. 1970

STATE OF MICHIGAN
COUNTY OF CRAWFORD

FILED FOR RECORD THIS
6th DAY OF June 1990 at
9:30 AM, in LIBER 2
PAGE 389
E. Richard Wisland
Register of Deeds

corners in
Crawford (County) Located In: Corner Code: E-3

Public Land Survey	T 26N R 1W	E-3
	T R	
	T R	
	T R	
Property Controlling in Section	S T R	
Miscellaneous	S T R	
Property In Sec.	S T R	

Register of Deeds Stamp & File Number

Lot No. _____, Recorded Plat _____
Private Claims _____


	A	B	C	D	E	F	G	H	I	J	K	L	M
2	6	5	4	3	2	1							
3													
4	7	8	9	10	11	12							
5													
6	13	17	16	15	14	13							
7													
8	19	20	21	22	23	24							
9													
10	30	29	28	27	26	25							
11													
12	31	32	33	34	35	36							
13													

Norman C. Caldwell in a field survey on March 19 90
I hereby certify that under requirements of P.A. 74, Michigan P.A. of 1970, the corner points mentioned in lines 1 and 2 above were in conformance with regulations and rules therefore as required in the current manual of survey instructions of the United States Department of the Interior, Bureau of Land Management or by a decree of a Court of Law and/or that the corner points mentioned in lines 3, 4 and 5 above were in conformance with the rules of the Michigan Board of Land Surveyors or by a Decree of a Court of Law; established, re-established, monumented, re-monumented, recovered, found as pressed below:

NOTE: Not more than 4 corners, all in the same town and range, may be recorded on this certificate.

Description of original monument and accessories and/or subsequent restoration:

- E-3) Post set by Pettibone, June 8, 1852.
Tamarack 13" N80°E .34 (22.44')
Tamarack 12" S60°E .21 (13.86')

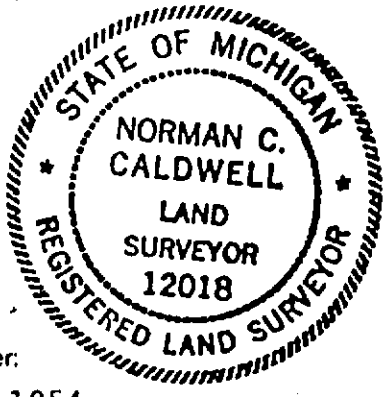

Description of corner evidence found and/or method applied in restoring or reestablishing corner:

- E-3) DNR pipe & cap placed from 2 original BTs June 15, 1954
1909 Fargo survey recovered old stake and Henning, LS 2240 marked NBTs
S10°W 11.6' Cedar
N55°E 27.1' 14" Cedar
S20°E 11.6' 10" Cedar
mon. recovered by Griffin, LS 13584, May 4, 1967 and recorded in L 1, pg 228

Description of monument for corner and accessories established to perpetuate locating the position of the corner:

- E-3) Sec. cor 4,5,8&9, T26N-R1W
Fnd. DNR pipe & cap. And is accepted as a careful & faithful perpetuation of the position of the orig. corner.
South 1' Carsonite Witness Post N80°E 22.4' orig. BT
N61°E 27.28' 8" W. Cedar (R) S60°E 13.2' orig. BT
S27°E 11.83' 8" W. Cedar (R)
S17°W 12.2' 11" Cedar (R)
N14°E 175.87' 11" Maple

Surveyor's Michigan License No. 12018 Date April 26, 1990