

LAND CORNER RECORDATION CERTIFICATE
Filing Requirement of Act 74, Mich. P.A. 1970

STATE OF MICHIGAN
COUNTY OF CRAWFORD

For corners in _____
Crawford (County)

Located In: _____ Corner Code: F-3

1. Public Land Survey T 26N R 1W _____
T _____ R _____
T _____ R _____
T _____ R _____

2. Property Controlling S _____ T _____ R _____
in Section S _____ T _____ R _____

3. Miscellaneous S _____ T _____ R _____
Property in Sec. S _____ T _____ R _____

FILED FOR RECORD THIS
6th DAY OF June 1990 AT
9:30 AM, IN LIBER 2
PAGE 390.
Elizabeth D. Whitcomb
Register of Deeds

Register of Deeds Stamp & File Number

4. Lot No. _____, Recorded Plat _____

5. Private Claims _____

	A	B	C	D	E	F	G	H	I	J	K	L	M
2	6		5		4		3		2		1		
3						●							
4	7		8		9		10		11		12		
5													
6	16		17		18		19		20		21		22
7													
8	19		20		21		22		23		24		
9													
10	30		29		28		27		26		25		
11													
12	31		32		33		34		35		36		
13													

Norman C. Caldwell in a field survey on March, 1990

do hereby certify that under requirements of P.A. 74, Michigan P.A. of 1970, the corner points mentioned in lines 1 and 2 above were in conformance with regulations and rules therefore as required in the current manual of survey instructions of the United States Department of the Interior, Bureau of Land Management or by a decree of a Court of Law and/or that the corner points mentioned in lines 3, 4 and 5 above were in conformance with the rules of the Michigan Board of Land Surveyors or by a Decree of a Court of Law; established, re-established, monumented, re-monumented, recovered, found as expressed below:

NOTE: Not more than 4 corners, all in the same town and range, may be recorded on this certificate.

Description of original monument and accessories and/or subsequent restoration:


(F-3) Post set by Pettibone, June 12, 1852.
Pine 10" S85°W .14 (9.24')
Balsm 10" S43°E .11 (7.26')

Description of corner evidence found and/or method applied in restoring or reestablishing corner:

(F-3) 1909 Fargo Eng. recovered one orig. BT Henning, LS 2240, could not identify position & placed 3/4" pipe at mid-point.
S29°E 31.7' 5" Maple
N64°W 43.0' 5" Maple
N14°W 30.7' 5" Balsm
Griffin, LS 13584, found pipe & replaced with U.S. Forest Service 6" x 5' conc. mon.
N81°E 82.10' 13" W. Pine
N43°W 56.89' SW cor. cabin
rec. in L 1, pg 227

Description of monument for corner and accessories established to perpetuate locating the position of the corner:

(F-3) 1/4 cor. 4&9, T26N-R1W
Fnd. 6" conc. mon w/3" brass cap 1.5' above ground. Accepted as a careful & faithful reestablishment of the position of the orig. cor.
North 1' Carsonite Witness Post
N78°E 5.8' 10" Maple
N28°W 36.7' 5" Maple
N86°W 33.5' 10" Maple
N43°W 56.9' SE cor. cabin

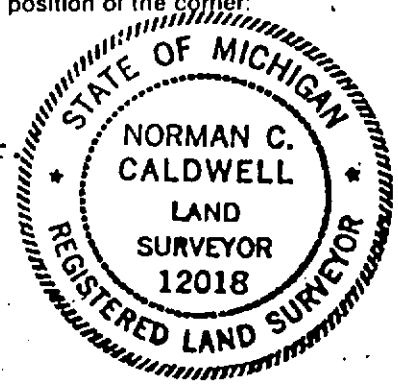

Signed by Norman C. Caldwell Date April 26, 1990

Surveyor's Michigan License No. 12018