

LAND CORNER RECORDATION CERTIFICATE
Filing Requirement of Act 74, Mich. P.A. 1970

STATE OF MICHIGAN
COUNTY OF CRAWFORD

or corners in

<u>Crawford</u> <small>(County)</small>	Located In:	Corner Code: <u>T1</u>
Public Land Survey	T <u>26N</u> R <u>1W</u>	<u>G-2</u>
	T _____ R _____	_____
	T _____ R _____	_____
	T _____ R _____	_____
Property Controlling in Section	S _____ T _____ R _____	_____
Miscellaneous	S _____ T _____ R _____	_____
Property in Sec.	S _____ T _____ R _____	_____

FILED FOR RECORD THE
6th DAY OF June 1990
9:30 AM, IN LIBER 2
PAGE 391
Richard D. Wieland
Register of Deeds

Register of Deeds Stamp & File Number

Lot No. _____, Recorded Plat _____
Private Claims _____

	A	B	C	D	E	F	G	H	I	J	K	L	M
2	8	5	4	3	2	1							
3													
4	7	6	5	4	3	2	1						
5													
6	18	17	16	15	14	13	12	11	10	9	8	7	6
7													
8	19	20	21	22	23	24	25	26	27	28	29	30	31
9													
10	30	29	28	27	26	25	24	23	22	21	20	19	18
11													
12	31	32	33	34	35	36	37	38	39	40	41	42	43
13													

Norman C. Caldwell in a field survey on March, 1990
I hereby certify that under requirements of P.A. 74, Michigan P.A. of 1970, the corner points mentioned in lines 1 and 2 above were in conformance with regulations and rules therefore as required in the current manual of survey instructions of the United States Department of the Interior, Bureau of Land Management or by a decree of a Court of Law and/or that the corner points mentioned in lines 3, 4 and 5 above were in conformance with the rules of the Michigan Board of Land Surveyors or by a Decree of a Court of Law; established, re-established, monumented, re-monumented, recovered, found as expressed below:


NOTE: Not more than 4 corners, all in the same town and range, may be recorded on this certificate.

Description of original monument and accessories and/or subsequent restoration:

- (G-2) Post set by Pettibone, June 8, 1852.
Pine 12" N11°W .06 (3.96')
Y. Oak 9" S62°E .23 (15.18')

Description of corner evidence found and/or method applied in restoring or reestablishing corner:

- (G-2) DNR pipe & cap placed by single proportion January 28, 1971 by K.J. Ostling, LS 10068.
N40°W 13.6' 6" Oak
N85°E 75.1' 13" R. Pine
rec. in L 1, pg 216

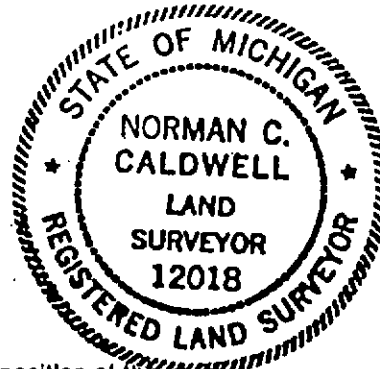

Description of monument for corner and accessories established to perpetuate locating the position of the corner:

- (G-2) 1/4 cor. 3&4, T26N-R1W
Fnd DNR pipe & cap. Accepted as a careful & faithful reestablishment of the position of the original corner.
North 1' Carsonite Witness Post N62°E 1.0' fnd. DNR wit. post
N85°E 75.6' 18" R. Pine (R) N40°W 13.6' 6" Oak stump (R)
S58°W 36.5' 6" R. Pine
S08°E 66.0' 3" W. Pine
N52°E 47.0' 5" R. Pine

Signed by Norman C. Caldwell Date April 26, 1990
Surveyor's Michigan License No. 12018