

LAND CORNER RECORDATION CERTIFICATE
Filing Requirement of Act 74, Mich. P.A. 1970

STATE OF MICHIGAN
COUNTY OF CRAWFORD

corners in

Crawford Located In: _____ Corner Code: H

Public Land Survey T 26N R 1W H-3

T _____ R _____

T _____ R _____

T _____ R _____

Property Controlling S _____ T _____ R _____

in Section S _____ T _____ R _____

Miscellaneous S _____ T _____ R _____

Property in Sec. S _____ T _____ R _____

FILED FOR RECORD THIS
6th DAY OF June 1990
9:30 AM IN LIBER 2
PAGE 392
Richard D. Williams
Register of Deeds

Register of Deeds Stamp & File Number

Lot No. _____ Recorded Plat _____
Private Claims _____

	A	B	C	D	E	F	G	H	I	J	K	L	M
2	6	5	4	3	2	1							
3								●					
4	7	8	9	10	11	12							
5													
6	16	17	18	19	20	21	22	23	24				
7													
8	19	20	21	22	23	24							
9													
10	30	29	28	27	26	25							
11													
12	31	32	33	34	35	36							
13													

Norman C. Caldwell in a field survey on March, 1990
I hereby certify that under requirements of P.A. 74, Michigan P.A. of 1970, the corner points mentioned in lines 1 and 2 above were in conformance with regulations and rules therefore as required in the current manual of survey instructions of the United States Department of the Interior, Bureau of Land Management or by a decree of a Court of Law and/or that the corner points mentioned in lines 3, 4 and 5 above were in conformance with the rules of the Michigan Board of Land Surveyors or by a Decree of a Court of Law; established, re-established, monumented, re-monumented, recovered, found as expressed below:

NOTE: Not more than 4 corners, all in the same town and range, may be recorded on this certificate.

Description of original monument and accessories and/or subsequent restoration:


H-3) Post set by Pettibone, June 8, 1852.
Pine 12" N1°E .32 (21.12')
Poplar 10" S47°W .13 1/2 (8.91')

Description of corner evidence found and/or method applied in restoring or reestablishing corner:

H-3) 1909 Fargo survey could not recover orig. mon. & placed mon. by single proportion.
J. Richardson fnd. Fargo cor. & placed 1/2" bar, 1930+ .
Henning, LS 2240, 1948 survey & R.T. Ostling, 1955 survey did not utilize this position but one 20.5' E & 7' N. They did not place a mon. at this position.
(It appears that this position was not utilized in other surveys.)
DNR pipe & cap placed by K.J. Ostling, LS 10068, Jan. 28. 1971, at the Fargo, Richardson, Edmands position.
N26°W 90.8 24" R. Pine
N50°E 103.3' 30" R. Pine
rec. in L 1, pg 222

Description of monument for corner and accessories established to perpetuate locating the position of the corner:

H-3) 1/4 cor. 3&10, T26N-R1W
Fnd. DNR pipe & cap. Accepted as a careful & faithful reestablishment of the position of the original corner.
North 1' Carsonite Witness Post
N26°W 91.5' 24" R. Pine (R)
N76°W 99.1' 8" R. Pine
N22°E 54.0' 15" Maple
S12°E 32.3' 10" Maple

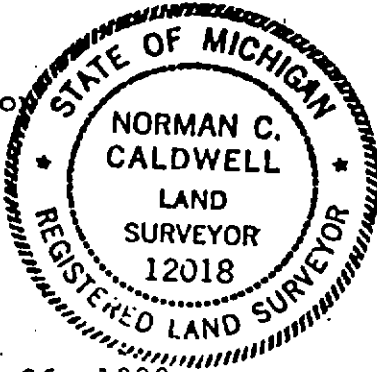

signed by Norman C. Caldwell Date April 26, 1990

Surveyor's Michigan License No. 12018