

LAND CORNER RECORDATION CERTIFICATE  
Filing Requirement of Act 74, Mich. P.A. 1970

STATE OF MICHIGAN  
COUNTY OF CRAWFORD

FILED FOR RECORD THIS  
*Caldwell* DAY OF *June*, 19*90*  
9:30 AM IN LIBER *2*  
PAGE *393*  
*Norman C. Caldwell*  
Register of Deeds

For corners in \_\_\_\_\_  
Crawford (County) Located In: \_\_\_\_\_ Corner Code: G-3

Public Land Survey T 26N R 1W \_\_\_\_\_  
T \_\_\_\_\_ R \_\_\_\_\_  
T \_\_\_\_\_ R \_\_\_\_\_  
T \_\_\_\_\_ R \_\_\_\_\_

Property Controlling S \_\_\_\_\_ T \_\_\_\_\_ R \_\_\_\_\_  
in Section S \_\_\_\_\_ T \_\_\_\_\_ R \_\_\_\_\_

Miscellaneous S \_\_\_\_\_ T \_\_\_\_\_ R \_\_\_\_\_  
Property in Sec. S \_\_\_\_\_ T \_\_\_\_\_ R \_\_\_\_\_

Register of Deeds Stamp & File Number


Lot No. \_\_\_\_\_, Recorded Plat \_\_\_\_\_  
Private Claims \_\_\_\_\_

	A	B	C	D	E	F	G	H	I	J	K	L	M
2	6	5	4	3	2	1							
3							●						
4	7	8	9	10	11	12							
5													
6	13	17	16	15	14	13							
7													
8	19	20	21	22	23	24							
9													
10	30	29	28	27	26	25							
11													
12	31	32	33	34	35	36							
13													

Norman C. Caldwell in a field survey on March, 1990  
I hereby certify that under requirements of P.A. 74, Michigan P.A. of 1970, the corner points mentioned in lines 1 and 2 above were in conformance with regulations and rules therefore as required in the current manual of survey instructions of the United States Department of the Interior, Bureau of Land Management or by a decree of a Court of Law and/or that the corner points mentioned in lines 3, 4 and 5 above were in conformance with the rules of the Michigan Board of Land Surveyors or by a Decree of a Court of Law; established, re-established, monumented, re-monumented, recovered, found as expressed below:

NOTE: Not more than 4 corners, all in the same town and range, may be recorded on this certificate.

Description of original monument and accessories and/or subsequent restoration:  
(G-3) Post set by Pettibone, June 8, 1852.  
Pine 13" N56°E  
Pine 16" S62°W

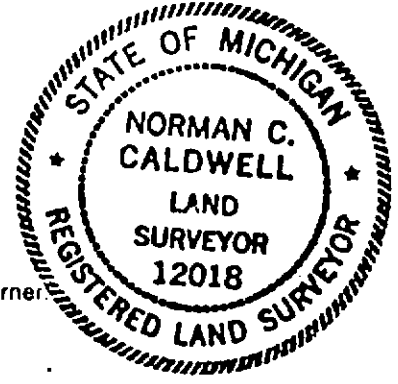

Description of corner evidence found and/or method applied in restoring or reestablishing corner:  
(G-3) 1909 survey by Fargo recovered a stake  
1913 survey by E. Houghton placed clay tile mon.  
1948 Henning survey, LS 2240, fnd. mon. & marked NBTs.  
N09°E 34.4' 8" Oak  
S43°E 37.7' 8" Oak  
N82°W 21.0' 9" Oak  
Griffin, LS 13584, fnd. clay tile mon. & replaced w/6" x 5' conc. post, rec. in L 1, pg 226.

Description of monument for corner and accessories established to perpetuate locating the position of the corner:  
(G-3) Sec. cor 3,4,9&10, T26N-R1W  
Fnd 6" dia. conc. mon w/brass cap at cor. fncs. S&W per Griffin corner form. And is accepted as a careful & faithful perpetuation of the position of the original corner.  
South 1' Carsonite Witness Post S38°W 54.1' 10" Blk Oak  
N12°E 34.52' 11" Blk. Oak (R) S04°W 18' P. Pole  
S84°E 91.50' 7" Twin Maple  
S34°E 37.81' 9" Blk. Oak (R)  
N75°W 21.22' 10" dead Blk. Oak stub (R)

Signed by Norman C. Caldwell Date April 26, 1990  
Surveyor's Michigan License No. 12018