

LAND CORNER RECORDATION CERTIFICATE  
Filing Requirement of Act 74, Mich. P.A. 1970

or corners in  
Crawford  
(County)

Located In: \_\_\_\_\_ Corner Code: I-2

Public Land Survey T 26N R 1W \_\_\_\_\_ I-2  
T \_\_\_\_\_ R \_\_\_\_\_  
T \_\_\_\_\_ R \_\_\_\_\_  
T \_\_\_\_\_ R \_\_\_\_\_

Property Controlling S \_\_\_\_\_ T \_\_\_\_\_ R \_\_\_\_\_  
in Section S \_\_\_\_\_ T \_\_\_\_\_ R \_\_\_\_\_  
Miscellaneous S \_\_\_\_\_ T \_\_\_\_\_ R \_\_\_\_\_  
Property In Sec. S \_\_\_\_\_ T \_\_\_\_\_ R \_\_\_\_\_

STATE OF MICHIGAN  
COUNTY OF CRAWFORD

FILED FOR RECORD THIS  
6th DAY OF June 1990  
9:30 am, IN LIBER 2  
PAGE 394

Elizabeth A. Williams  
Register of Deeds

Register of Deeds Stamp & File Number

Lot No. \_\_\_\_\_, Recorded Plat \_\_\_\_\_  
Private Claims \_\_\_\_\_

|    | A  | B | C  | D | E  | F | G  | H | I  | J | K  | L | M |
|----|----|---|----|---|----|---|----|---|----|---|----|---|---|
| 2  | 6  |   | 5  |   | 4  |   | 3  | ● | 2  |   |    |   |   |
| 3  |    |   |    |   |    |   |    |   |    |   |    |   |   |
| 4  | 7  |   | 8  |   | 9  |   | 10 |   | 11 |   | 12 |   |   |
| 5  |    |   |    |   |    |   |    |   |    |   |    |   |   |
| 6  | 13 |   | 14 |   | 15 |   | 16 |   | 17 |   | 18 |   |   |
| 7  |    |   |    |   |    |   |    |   |    |   |    |   |   |
| 8  | 19 |   | 20 |   | 21 |   | 22 |   | 23 |   | 24 |   |   |
| 9  |    |   |    |   |    |   |    |   |    |   |    |   |   |
| 10 | 25 |   | 26 |   | 27 |   | 28 |   | 29 |   | 30 |   |   |
| 11 |    |   |    |   |    |   |    |   |    |   |    |   |   |
| 12 | 31 |   | 32 |   | 33 |   | 34 |   | 35 |   | 36 |   |   |
| 13 |    |   |    |   |    |   |    |   |    |   |    |   |   |

Norman C. Caldwell in a field survey on March, 1990  
I hereby certify that under requirements of P.A. 74, Michigan P.A. of 1970, the corner points mentioned in lines 1 and 2 above were in conformance with regulations and rules therefore as required in the current manual of survey instructions of the United States Department of the Interior, Bureau of Land Management or by a decree of a Court of Law and/or that the corner points mentioned in lines 3, 4 and 5 above were in conformance with the rules of the Michigan Board of Land Surveyors or by a Decree of a Court of Law; established, re-established, monumented, re-monumented, recovered, found as expressed below:


NOTE: Not more than 4 corners, all in the same town and range, may be recorded on this certificate.

Description of original monument and accessories and/or subsequent restoration:

(I-2) Post set by Pettibone, May 29, 1852.  
Tamarack 12" East .32 (21.12')  
Tamarack 9" S28°W .18 (11.88')

Description of corner evidence found and/or method applied in restoring or reestablishing corner:

(I-2) 1909 Fargo survey fnd. one orig. BT.  
Henning, LS 2240, fnd. & accepted this position  
K.J. Ostling, LS 10068, placed DNR pipe & cap 8-19-70  
S32°E 12.2 5" Cedar  
S20°W 20.5' 12" W. Pine  
rec. in L 1, pg 215

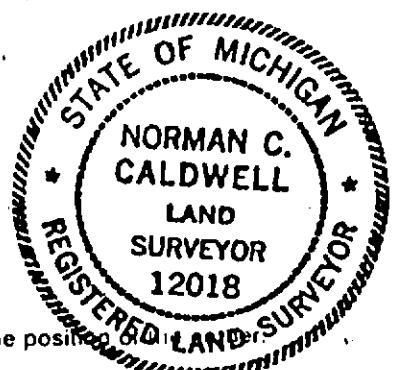

Description of monument for corner and accessories established to perpetuate locating the position:

(I-2) 1/4 cor. 2&3, T26N-R1W  
Fnd. DNR pipe & cap. And is accepted as a careful & faithful perpetuation of the position of the original corner.  
North 1' Carsonite Witness Post S32°W 12.4' 7" Cedar  
N48°W 6.4' 7" Spruce East 21.1' possible US BT  
N74°E 10.7' 6" Spruce  
S36°E 12.3' 5" Cedar (R)  
S14°W 21.0' 14" W. Pine (R)

Signed by Norman C. Caldwell Date April 26, 1990  
Surveyor's Michigan License No. 12018